


STATE OF KANSAS
STATE CORPORATION COMMISSION
Give All Information Completely
Make Required Affidavit
Mail or Deliver Report to:
Conservation Division
State Corporation Commission,
800 Bitting Building
Wichita, Kansas

RECEIVED
OCT 11 1937
H

WELL PLUGGING RECORD
OR
FORMATION PLUGGING RECORD

Strike out upper line
when reporting plugging
of formations.

NORTH
M I A M I County. Sec. 29 Twp. 17 Rge. 23 (E) (W)

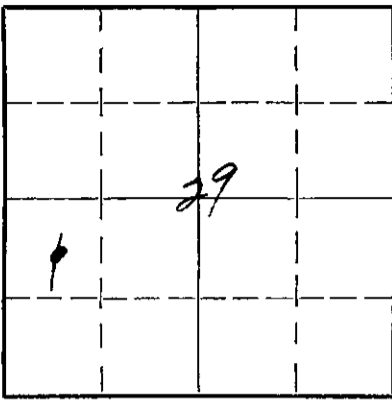

Locate well correctly on above
Section Plat

Location as "NE 1/4 NW 1/4 SW 1/4" or footage from lines
Lease Owner KANSAN OIL CORPORATION
Lease Name Wallace Well No. 3
Office Address 302 Midland Bldg., Kansas City, Missouri
Character of Well (Completed as Oil, Gas or Dry Hole) DRY HOLE
Date, well completed September 10 1937
Application for plugging filed September 10 1937
Application for plugging approved 1937
Plugging Commenced September 10 1937
Plugging Completed " " 1937
Reason for abandonment of well or producing formation
Dry Hole
If a producing well is abandoned, date of last production 1937
Was permission obtained from the Conservation Division or its agents before plugging was commenced?
Yes

Name of Conservation Agent who supervised plugging of this well
Producing formation Depth to top Bottom Total Depth of Well 527 Feet
Show depth and thickness of all water, oil and gas formations.

OIL, GAS OR WATER RECORDS

CASING RECORD

Formation	Content	From	To	Size	Put In	Pulled Out
				8	17	17
				6 1/4	170	170
				4 3/8	333	333

Describe in detail the manner in which the well was plugged, indicating where the mud fluid was placed and the method or methods used in introducing it into the hole. If cement or other plugs were used, state the character of same and depth placed, from feet to feet for each plug set.

Well filled shale & rock full.

PLUGGING
FILE NO 29-17-23E
BOOK PAGE 112 LINE 35

(If additional description is necessary use BACK of this sheet)
Correspondence regarding this well should be addressed to R. D. JAMESON
Address LA CYGNE, KANSAS

STATE OF KANSAS, COUNTY OF LINN, ss.
R. D. JAMESON (employee of owner) or (operator) of the above-described well,
being first duly sworn on oath, says: That I have knowledge of the facts, statements, and matters herein contained and the log of the above-described well as filed and that the same are true and correct. So help me God.

(Signature) R. D. Jameson

La Cygne, Kansas
(Address)

SUBSCRIBED AND SWORN to before me this 10th day of September, 1937

My commission expires Feb 30 1944

A. Stolper
Notary Public.

RECEIVED
OCT 11 1937

WALLACE NO. 3
 (Dry Hole)

Farm: WALLACE
 SE 1/4 29-17-23
 Miami County
 Kansas

Drilling Contractor: Art Sands
 Tool Dresser : Lewis Wallace
 Commenced: August 17, 1937

Total Depth: 527 ft.

Thickness of Strata	Formation	Total Depth	Remarks
3	Soil	3	
4	Shell Lime	7	
10	Shale	17	
2	Lime	19	
18	Shale	37	
3	Lime	40	
42	Shale	82	
15	Lime	97	
10	Shale	107	
29	Lime	136	
3	Black Slate	139	Gas Bubbles
4	Shale	143	
20	Lime	163	Hole full water at 160
1	Shale	164	
2	Coal	166	
2	Lime	168	
2	Shale	170	
2	Lime	172	
4	Shale	176	
7	Lime	183	
2	Shale	185	
1	Lime	186	
111	Shale	297	
5	Sandy Shale	302	
15	Green Shale	317	S.L.M. 317
1	Lime	318	
4 1/2	Green Shale	322 1/2	
6 1/2	Dark Shale	329	
4	Light Shale	333	Reduced hole to 4 7/8
2	Light Shale	335	
5	Sandy Lime	340	S.L.M. 342
9	Light Shale	349	S.L.M. 351
5	Oil Sand	354	Showing
20	Shale	374	S.L.M. 383
9	Lime	383	Brown Lime Hard
2	Shale	385	
2	Lime Shells	387	
4	Dark Shale	391	
3	Lime	394	
4	Black Shale	398	Little gas

PLUGGING
 FILE SEC 29 17 23E
 BOOK PAGE 112 LINE 35

7	Shale	405	
5	Lime	410	
5	Shale, sandy	415	
9	Dark Shale	424	
7	Lime	431	S.L.M. 431
3	Black Slate	434	Little Gas
2	Shale	436	
2	Lime	438	
1	Shale	439	
5	Lime	444	
14	Green Shale	458	
2	Lime	460	
2	Dark Shale	462	
4	Lime	466	
5	Dark Shale	471	S.L.M. 471
3	Black Slate	474	Little Gas
6	Shale	480	
3	Lime	483	
5	Dark Shale	488	
4	Sand, broken	492	Little Gas
7	Sandy Shale	499	
11	Dark Shale	510	
10	Light Shale	520	
2	Dark Shale	522	
2	Lime	524	
3	Black Slate	527	Water and no gas. Dry Hole--no oil.

Total Depth 527 ft.

PLUGGING
 FILE SEC 29 T 17 R 33 E
 BOOK - PAGE 112 LINE 35