

STATE OF KANSAS
STATE CORPORATION COMMISSION


WELL PLUGGING RECORD

Give All Information Completely
Make Required Affidavit
Mail or Deliver Report to:
Conservation Division
State Corporation Commission
800 Bitting Building
Wichita, Kansas

OR
FORMATION PLUGGING RECORD

Strike out upper line
when reporting plug-
ging off formations.

Miami County, Sec. 29 Twp. 17 Rge. 23 (E).....(W)
Location as "NE1/4NW1/4SW1/4" or footage from lines E 1/2 of SW 1/4

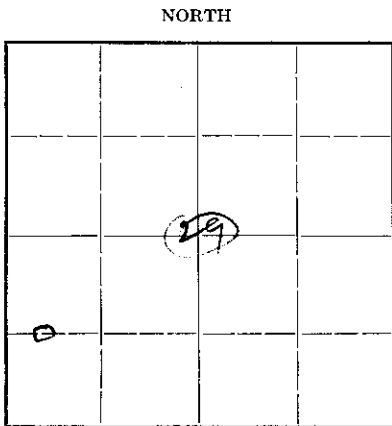

Locate well correctly on above
Section Plat

Lease Owner James Moberly
Lease Name Albert Moberly Well No. 1
Office Address Paula St
Character of Well (completed as Oil, Gas or Dry Hole) dry
Date well completed Jan 21 1942
Application for plugging filed Jan 21 1942
Application for plugging approved Jan 21 1942
Plugging commenced Jan 21 1942
Plugging completed Jan 24 1942
Reason for abandonment of well or producing formation dry

If a producing well is abandoned, date of last production dry 19.....

Was permission obtained from the Conservation Division or its agents before plugging was commenced? yes Capt. M. Stearn

Name of Conservation Agent who supervised plugging of this well.....
Producing formation none Depth to top..... Bottom..... Total Depth of Well 546 Feet

Show depth and thickness of all water, oil and gas formations.

OIL, GAS OR WATER RECORDS


CASING RECORD

Formation	Content	From	To	Size	Put In	Pulled Out
				8"	16	16
				6"	337	337

Describe in detail the manner in which the well was plugged, indicating where the mud fluid was placed and the method or methods used in introducing it into the hole. If cement or other plugs were used, state the character of same and depth placed, from..... feet to..... feet for each plug set.

mud to 480
Bridge @ 385
mud to 315
cement to 300
Bridge @ 130
mud to 90
cement to 75
Bridge @ 25
earth to surface

pd. 1/28/42
K.O.

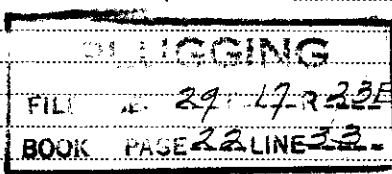

01-28-42

(If additional description is necessary, use BACK of this sheet)

Correspondence regarding this well should be addressed to
Address.....

STATE OF....., COUNTY OF....., ss.

..... (employee of owner) or (owner or operator) of the above-described well, being first duly sworn on oath, says: That I have knowledge of the facts, statements, and matters herein contained and the log of the above-described well as filed and that the same are true and correct. So help me God.

(Signature) John Basley

(Address)

SUBSCRIBED AND SWORN to before me this 26 day of Jan, 1942

Wood Mills
Notary Public.

My commission expires.....

Log of Moberly #1, E 1/2 - sw 1/4 29-17-23E, Miami County

Plugged: Jan 24, 1942

Operator: John Bosley, Paola, Kansas

8" @ 16' 6 1/4" @ 337'

surface	3
shelly lime	7
shale	15
lime	25
shale	40
lime	43
shale	59
lime	67
shale	80
lime	98
shale	107
lime	136
shale	145
lime	164
shale	168
lime	173
shale	177
lime	182
shale	186
sand	190
shale	337
lime	340
shale	347
sandy lime	365
" shale	380
lime	386
shale	391
lime	394
shale	401
lime	403
shale	406
lime	413
shale	433
lime	437
shale	441
lime	445
shale	447
lime	451
shale	472
lime	475
shale	477
lime	478
slate	480
shale	485
lime	489
shale	527
lime	530
shale	546 TD.



PLUGGING
 FILE NO. 29 17-23E
 BOOK PAGE 22 LINE 33



STATE OF KANSAS
STATE CORPORATION COMMISSION
CONSERVATION DIVISION
800 BITTING BUILDING
WICHITA, KANSAS

IN REPLY PLEASE
REFER TO THIS
SUBJECT

DAILY REPORT
CONSERVATION AGENTS

T. A. MORGAN, DIRECTOR
CONSERVATION DIVISION
STATE CORPORATION COMMISSION
800 BITTING BUILDING
WICHITA, KANSAS

DATE _____

LEFT _____ KANSAS AT _____ A.M. RETURNED TO _____
A.M. P.M.
AT _____ P.M. _____

PURPOSE OF TRIP
POTENTIALS AS FOLLOWS: (SHOW REASON FOR DELAYED AND INCOMPLETE TESTS)

REMARKS: (INCLUDE PLUGGING REPORTS--SPECIAL TRIPS--INVESTIGATIONS--ETC.)

TOTAL MILEAGE FOR THE DAY _____

(SIGNED) _____

(Use Reverse Side for Any Additional Information)