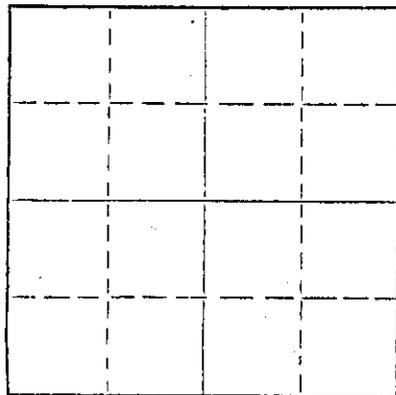


Give All Information Completely
 Make Required Affidavit
 Mail or Deliver Report to:
 Conservation Division
 State Corporation Commission
 P. O. Box 17027
 Wichita, Kansas 67217
 NORTH

WELL PLUGGING RECORD



Locate well correctly on above Section Plat

Lane _____ County, Sec. 20 Twp. 20S Rge. _____ (E) 30 (W)
 Location as "NE/CNWxSWx" or footage from lines: NW NW
 Lease Owner Chief Drilling Co., Inc.
 Lease Name Cole Well No. #1
 Office Address 905 Century Plaza, Wichita, Kansas 67202
 Character of Well (completed as Oil, Gas or Dry Hole) Dry Hole
 Date well completed September 28, 1978 19____
 Application for plugging filed September 29, 1978 19____
 Application for plugging approved September 28, 1978 19____
 Plugging commenced September 28, 1978 19____
 Plugging completed September 28, 1978 19____
 Reason for abandonment of well or producing formation Dry hole

If a producing well is abandoned, date of last production _____ 19____
 Was permission obtained from the Conservation Division or its agents before plugging was commenced? Yes

Name of Conservation Agent who supervised plugging of this well _____
 Producing formation _____ Depth to top _____ Bottom _____ Total Depth of Well 4680' Feet
 Show depth and thickness of all water, oil and gas formations.

OIL, GAS OR WATER RECORDS

CASING RECORD

FORMATION	CONTENT	FROM	TO	SIZE	PUT IN	PULLED OUT
		0	302'	8 5/8"		

Describe in detail the manner in which the well was plugged, indicating where the mud fluid was placed and the method or methods used in introducing it into the hole. If cement or other plugs were used, state the character of same and depth placed, from _____ feet to _____ feet for each plug set.

Plugged through drill pipe @ 650' w/70 sx. 50-50 Posmix, 6% gel
 Plugged through drill pipe @ 240 w/20 sx. " " "
 Plugged through drill pipe @ 40' w/10 sx. " " "

RECEIVED
 STATE CORPORATION COMMISSION
 10-3-78
 OCT - 3 1978

CONSERVATION DIVISION
 Wichita, Kansas

(If additional description is necessary, use BACK of this sheet)
 Name of Plugging Contractor Chief Drilling Co., Inc.
 Address 905 Century Plaza, Wichita, Kansas 67202

STATE OF KANSAS, COUNTY OF SEDGWICK, ss.
Jim Robinson (employee of owner) or (owner or operator) of the above-described well, being first duly sworn on oath, says: That I have knowledge of the facts, statements, and matters herein contained and the log of the above-described well as filed and that the same are true and correct. So help me God.

(Signature) Jim Robinson
905 Century Plaza, Wichita, Kansas 67202
 (Address)

SUBSCRIBED AND SWORN TO before me this 29th day of September, 19 78

Marilyn Sinard
 Marilyn Sinard Notary Public.

My commission expires _____
MARILYN SINARD
 STATE NOTARY PUBLIC
 SEDGWICK COUNTY, KANSAS
 MY COMM. EXP. APR. 30, 1979

WELL LOG

CHIEF DRILLING CO., INC.
905 Century Plaza
Wichita, Kansas 67202

15701-20323-0000

#1 COLE
NW NW Sec. 20-20S-30W
Lane County, Kansas

CONTRACTOR: Warrior Drilling, Inc.
CASING RECORD: 8 5/8" @ 302' w/175 sx.

COMMENCED: Sept. 18, 1978
COMPLETED: Sept. 28, 1978

<u>FORMATION</u>	<u>FROM</u>	<u>TO</u>	<u>ELEVATIONS</u>
Shale	0	307	2820 Gr.
Sand & Shale	307	2740	2823 D.F.
Shale	2740	3679	2825 K.B.
Shale & Lime	3679	4045	
Shale	4045	4312	
Shale & Lime	4312	4636	
Lime	4636	4680	
RTD	4680		

D & A

RECEIVED
STATE CORPORATION COMMISSION

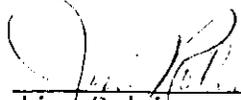
OCT - 8 1978

CONSERVATION DIVISION
Wichita, Kansas

STATE OF KANSAS, COUNTY OF SEDGWICK) ss:

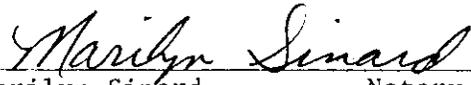
I hereby certify that the above is a true and correct copy of the Driller's Log of the well drilled in the NW NW of Section 20-20S-30W, Lane County, Kansas, to the best of my knowledge and belief.

CHIEF DRILLING CO., INC.


Jim Robinson, Vice-President

Subscribed and sworn to before me this 29th day of September, 1978.

MARILYN SINARD
STATE NOTARY PUBLIC
SEDGWICK COUNTY, KANSAS
MY COMM. EXP. APR. 30, 1979


Marilyn Sinard Notary Public