


STATE OF KANSAS  
STATE CORPORATION COMMISSION

Give All Information Completely  
Make Required Affidavit  
Mail or Deliver Report to:  
Conservation Division  
State Corporation Commission  
P. O. Box 17027  
Wichita, Kansas 67217  
NORTH

WELL PLUGGING RECORD

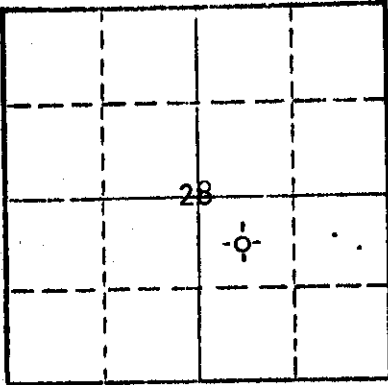

Locate well correctly on above  
Section Plat

Lane \_\_\_\_\_ County, Sec. 28 Twp. 16S Rge. (E) 27 (W)  
Location as "NE/CNW/SE" or footage from line C W/2 NW SE  
Lease Owner Petroleum, Inc.  
Lease Name Beougher Well No. 1  
Office Address 300 West Douglas, Wichita, Kansas 67202  
Character of Well (completed as Oil, Gas or Dry Hole) Dry Hole  
Date well completed January 21 19 74  
Application for plugging filed January 21 19 74  
Application for plugging approved January 21 19 74  
Plugging commenced January 21 19 74  
Plugging completed January 21 19 74  
Reason for abandonment of well or producing formation Too low structurally

If a producing well is abandoned, date of last production \_\_\_\_\_ 19 \_\_\_\_  
Was permission obtained from the Conservation Division or its agents before plugging was commenced? Yes

Name of Conservation Agent who supervised plugging of this well W. L. Nichols, Morland, Kansas  
Producing formation \_\_\_\_\_ Depth to top \_\_\_\_\_ Bottom \_\_\_\_\_ Total Depth of Well \_\_\_\_\_ Feet  
Show depth and thickness of all water, oil and gas formations.

OIL, GAS OR WATER RECORDS

CASING RECORD

FORMATION	CONTENT	FROM	TO	SIZE	PUT IN	PULLED OUT
				8 5/8"	279.31'	None

Describe in detail the manner in which the well was plugged, indicating where the mud fluid was placed and the method or methods used in introducing it into the hole. If cement or other plugs were used, state the character of same and depth placed, from \_\_\_\_\_ feet to \_\_\_\_\_ feet for each plug set.

Filled with heavy mud to 975'. Set plug. Put in 110 sacks cement. Filled with heavy mud to 310'. Set plug. Put in 30 sacks cement. Filled with heavy mud to 40'. Set plug. Filled to top with 10 sacks cement.

RECEIVED  
STATE CORPORATION COMMISSION  
FEB 22 1974  
CONSERVATION DIVISION  
Wichita, Kansas

(If additional description is necessary, use BACK of this sheet)  
Name of Plugging Contractor C-G Drilling Co.  
Address 1107 Union National Building, Wichita, Kansas 67202

STATE OF Kansas, COUNTY OF Sedgwick, ss.  
Jay H. Galloway (employee of owner) or (owner or operator) of the above-described well, being first duly sworn on oath, says: That I have knowledge of the facts, statements, and matters herein contained and the log of the above-described well as filed and that the same are true and correct. So help me God.

(Signature) Jay H. Galloway  
1107 Union National Bldg  
Wichita, Ks.  
19 74



Phyllis Buchanan  
Notary Public.

WELL LOG

15101-20086-0000

OPERATOR: PETROLEUM, INC.

WELL NAME: BEOUGHER #1 LOCATION: W/2 NW SE SECTION 28-16S-27W

COUNTY: LANE STATE: KANSAS

WELL COMMENCED: JAN 6 '74 WELL COMPLETED: JAN 21 '74

ELEVATION: 2702 KB TOTAL DEPTH: 4626

PRODUCTION: DRY & ABANDONED RIG NO: 1

CASING - 8-5/8": SET @ 279.31' (7 JTS) NEW 20# W/200 SX CEMENT

5-1/2": \_\_\_\_\_

ALL MEASUREMENTS TAKEN FROM THE TOP OF ROTARY BUSHING:

FROM	TO	FORMATION	DEVIATION FROM VERTICAL	REMARKS:
0	640	SHALE & SAND		
640	995	SHALE		
995	1055	SAND		
1055	1440	SHALE & RED BED		
1440	1885	SHALE & SAND		
1885	2127	RED BED & SHALE		
2127	2167	ANHYDRITE	1° @ 2150'	
2167	2195	SHALE		
2195	2320	SHALE & SHELLS		
2320	3643	LIME & SHALE		
3643	4611	LIME		
4611	4626	MISSISSIPPI		
4626		RTD		

RECEIVED  
STATE CORPORATION COMMISSION

FEB 22 1974

CONSERVATION DIVISION  
Wichita, Kansas

DST #1 4057'-4080  
 Open 30 SI 30 Open 30 SI 60  
 Rec 125' muddy water  
 IBHP 1189# FBHP 1211#  
 IFP 26# FFP 58#

DST #2 4191'-4227'  
 Open 30 SI 30 Open 30 SI 30  
 Rec 50' watery mud  
 IBHP 987# FBHP 902#  
 IFP 58# FFP 69#

DST #3 4221'-4241'  
 Open 30 SI 30 Open 30 SI 30  
 Rec 600' salt water, top  
 60' few specks oil  
 IBHP 913# FBHP 819#  
 IFP 32# FFP 292#

DST #4 4599'-4611' Open 30  
 SI 30 Open 30 SI 30 Rec 15'  
 mud IBHP 26# FBHP 26#  
 IFP 26# FFP 26#

DST #5 Straddle test 4273-4289  
 Open 30 SI 30 Open 30 SI 30  
 Rec 65' mud w/few specks oil  
 IBHP 920# FBHP 87# IFP 10#  
 FFP 15#

DST #6 Straddle test 4585'4608  
 Open 30 SI 30 Open 30 SI 30  
 Rec. 40' thin mud IBHP

STATE OF KANSAS )  
COUNTY OF SEDGWICK) SS: 1157# FBHP 1115# IFP 45# FFP 58#

The undersigned hereby certifies that to the best of his knowledge and belief, the above facts are true and correct.

C-G DRILLING CO.

By Jay H. Galloway  
Jay H. Galloway

SUBSCRIBED AND SWORN TO, BEFORE ME, This 1st day of February, 1974.

MY COMM. EXP. DEC. 7, 1975

Phyllis Buchanan  
PHYLLIS BUCHANAN - NOTARY PUBLIC

