

STATE OF KANSAS
STATE CORPORATION COMMISSION


WELL PLUGGING RECORD

15101-20215-0000

Give All Information Completely
Make Required Affidavit
Mail or Deliver Report to
Conservation Division
State Corporation Comm.
245 North Water
Wichita, KS 67202

Lane _____ County. Sec. 27 Twp. 16 Rge. 27 ~~E/W~~
Location as "NE/CNW 1/4 SW 1/4" or footage from lines
C E 1/2, SE 1/2, SW 1/2

Lease Owner Helmerich & Payne Inc.
Lease Name Jones "F" Well No. 1
Office Address Box 558, Garden City, Kansas 67846
Character of Well (Completed as Oil, Gas or Dry Hole) _____

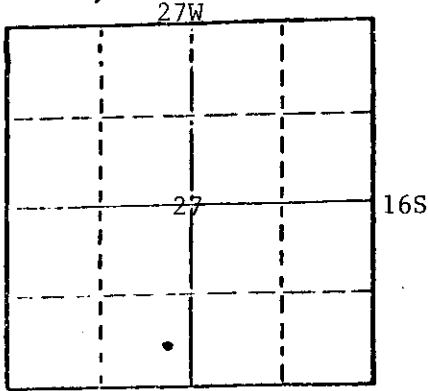

Locate well correctly on above Section Plot

Dry Hole _____
Date Well completed _____ 3-30 1977
Application for plugging filed 4-5 1977
Application for plugging approved 4-7 1977
Plugging commenced 4-9 1977
Plugging completed 4-12 1977

Reason for abandonment of well or producing formation _____
Non Commercial Value
If a producing well is abandoned, date of last production _____
No production 19____
Was permission obtained from the Conservation Division or its agents before plugging was commenced? Yes

Name of Conservation Agent who supervised plugging of this well Mr. Balthazor
Producing formation None Depth to top _____ Bottom _____ Total Depth of Well 4600'
Show depth and thickness of all water, oil and gas formations.

OIL, GAS OR WATER RECORDS

CASING RECORD

FORMATION	CONTENT	FROM	TO	SIZE	PUT IN	PULLED OUT
Surface		0'	335'	8 5/8"	335'	0'
Production		0'	4293'	5 1/2"	4293'	2773'

Describe in detail the manner in which the well was plugged, indicating where the mud fluid was placed and the method or methods used in introducing it into the hold. If cement or other plugs were used, state the character of same and depth placed, from _____ feet to _____ feet for each plug set.

Pumped 2 sacks Hulls & 15 sacks cement to 4020'-Pressured to 750 lbs.
Displaced w/ mud 4020' to 900'
Spotted 70 sacks cement 900' to 690'
Displaced w/ mud 690' to 330'
Spotted 25 sacks cement 330' to 255'
Layed down rest of 5 1/2" casing.
Put bridge & 10 sacks cement 40' to 0'
Cut off 8 5/8" 42" below ground level.

RECEIVED
STATE CORPORATION COMMISSION
APR 19 1977
4-19-77
CONSERVATION DIVISION

(If additional description is necessary, use BACK of this sheet)

Name of Plugging Contractor Midwest Casing Pulling
Box F, Sublette, Kansas 67877 Kans. Permit # 766

STATE OF KANSAS COUNTY OF Haskell, ss.

Edgar J. Eves (employee of owner) or ~~(owner or operator)~~
of the above-described well, being first duly sworn on oath, says: That I have knowledge of the facts, statements, and matters herein contained and the log of the above-described well as filed and that the same are true and correct. So help me God,

(Signature) Edgar J. Eves
Box F, Sublette, Kansas 67877
(Address)

SUBSCRIBED AND SWORN TO before me this 13th day of April, 19 77

Sandra L. Eves
Notary Public.

My commission expires 12-8-80

