


15-101-19025-0000  
WELL PLUGGING RECORD

Give All Information Completely  
Make Required Affidavit  
Mail or Deliver Report to:  
Conservation Division  
State Corporation Commission  
211 No. Broadway  
Wichita, Kansas

Lane \_\_\_\_\_ County. Sec. 32 Twp. 20S Rge. 27 ~~W~~ W (W)  
Location as "NE/CNW/SW" or footage from lines 100' E. of C-SE-NW  
Lease Owner Socony Mobil Oil Co., Inc.  
Lease Name Emmett Winans Well No. 1  
Office Address 300 North Broadway - Wichita 2, Kansas  
Character of Well (completed as Oil, Gas or Dry Hole) Dry Hole  
Date well completed P & A Complete 5-29-63 19  
Application for plugging filed 6-4-63 19  
Application for plugging approved 5-29-63 19  
Plugging commenced 5-29-63 19  
Plugging completed 5-29-63 19  
Reason for abandonment of well or producing formation Dry Hole

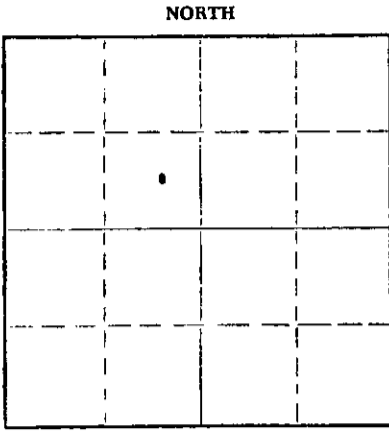

Locate well correctly on above Section Plat

If a producing well is abandoned, date of last production \_\_\_\_\_ 19  
Was permission obtained from the Conservation Division or its agents before plugging was commenced? Yes

Name of Conservation Agent who supervised plugging of this well W. L. Nichols  
Producing formation -- Depth to top \_\_\_\_\_ Bottom \_\_\_\_\_ Total Depth of Well \_\_\_\_\_ Feet  
Show depth and thickness of all water, oil and gas formations.

OIL, GAS OR WATER RECORDS

CASING RECORD

FORMATION	CONTENT	FROM	TO	SIZE	PUT IN	PULLED OUT
				8 5/8"	515'	0

Describe in detail the manner in which the well was plugged, indicating where the mud fluid was placed and the method or methods used in introducing it into the hole. If cement or other plugs were used, state the character of same and depth placed, from \_\_\_\_\_ feet to \_\_\_\_\_ feet for each plug set.  
Spotted 20 Sk. common cement @ 530'. Filled surface pipe w/mud to 60'. Spotted 20 Sk. common 60' to surface P top.

STATE CORPORATION COMMISSION

JUN 5 1963  
6-5-63  
CONSERVATION DIVISION  
Wichita, Kansas

(If additional description is necessary, use BACK of this sheet)

Name of Plugging Contractor Garvey Drilling Company  
Address 352 North Broadway, Wichita, Kansas

STATE OF Kansas, COUNTY OF Sedgwick, ss.  
L. L. Davis (employee of owner) or (owner or operator) of the above-described well, being first duly sworn on oath, says: That I have knowledge of the facts, statements, and matters herein contained and the log of the above-described well as filed and that the same are true and correct. So help me God

(Signature) L. L. Davis  
300 North Broadway - Wichita 2, Kansas  
(Address)

SUBSCRIBED AND SWORN TO before me this 4th day of June, 1963

My commission expires 4-4-66 Jack Bearden Notary Public.

# WELL LOG

15101 19025 0000

COMPANY Mobil Oil Company

SEC. 32 T. 20S R. 27W

FARM Winans

NO. 1

LOC. C SE NW


TOTAL DEPTH 4917'

COUNTY Lane

COMM. 5-6-63

COMP. 5-29-63

CONTRACTOR Garvey Drilling Company

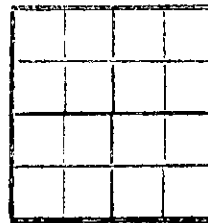

CASING 8 5/8" @ 513' w/400 sx

ELEVATION 3614' DF

PRODUCTION D & A

FIGURES INDICATE BOTTOM OF FORMATIONS

45' Surface Rock Sand  
 515' Post Rock Shale  
 1130' Shale and Sand  
 1400' Red Bed  
 1600' Sand  
 1685' Shale, Sand, and Shells  
 1915' Shale and Sand  
 2445' Shale  
 2610' Shale w/Lime Streaks  
 2664' Shale and Lime  
 2790' Lime and Shale  
 2865' Lime  
 3055' Lime and Shale  
 3140' Lime and Shale w/Chalk Streaks  
 3578' Lime and Shale  
 3659' Shale and Lime  
 3845' Lime and Shale  
 3911' Lime  
 3950' Lime and Shale  
 4000' Lime  
 4140' Lime and Shale  
 4516' Lime  
 4595' Chert  
 4650' Chert and Lime  
 4708' Lime and Chert  
 4775' Lime and Shale  
 4815' Lime  
 4837' Lime and Chert  
 4850' Lime  
 4900' Lime and Chert  
 4917' Lime  
 4917' RTD

RECEIVED  
STATE CORPORATION COMMISSION

JUN 26 1963

CONSERVATION DIVISION  
Wichita, Kansas

State of Kansas

County of Lane

I, Sam N. Stephens of Garvey Drilling Company

upon oath state the above and foregoing is a true and correct copy of the log of the Winans #1 well.

Sam N. Stephens

Subscribed and sworn to before me this 5th day of June 19 63

My Commission Expires: October 24th, 1966

Beaufort  
NOTARY PUBLIC