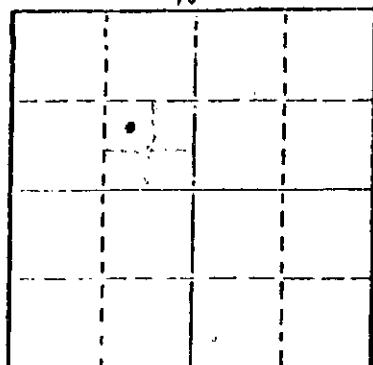


STATE OF KANSAS
STATE CORPORATION COMMISSION

Give All Information Completely
Make Required Affidavit
Mail or Deliver Report to
Conservation Division
State Corporation Comm.
245 North Water
Wichita, KS 67202

Locate well correctly on above
Section Plat

WELL PLUGGING RECORD

Lane _____ County. Sec. 8 Twp. 18S Rge. 29W E/W
Location as "NE/CNW, SW 1/4" or footage from lines _____
NW SE NW

Lease Owner Mull Drilling Company, Inc.

Lease Name Waterson Trust # 1 Well No. 1

Office Address 221 N. Main Suite 300, Wichita, KS 67202

Character of Well (Completed as Oil, Gas or Dry Hole) _____

DRY HOLE

Date Well completed March 20, 1981

Application for plugging filed March 20, 1981

Application for plugging approved March 20, 1981

Plugging commenced March 20, 1981

Plugging completed March 20, 1981

Reason for abandonment of well or producing formation _____

DRY HOLE

If a producing well is abandoned, date of last production

19

Was permission obtained from the Conservation Division or
its agents before plugging was commenced? YES

Name of Conservation Agent who supervised plugging of this well Gilbert Balthazor
Producing formation _____ Depth to top _____ Bottom _____ Total Depth of Well _____
Show depth and thickness of all water, oil and gas formations.

OIL, GAS OR WATER RECORDS

CASING RECORD

FORMATION	CONTENT	FROM	TO	SIZE	PUT IN	PULLED OUT
		0	318.42	8 5/8	328'	0

Describe in detail the manner in which the well was plugged, indicating where the mud fluid was placed and the method or methods used in introducing it into the hole. If cement or other plugs were used, state the character of same and depth placed, from _____ feet to _____ feet for each plug set.

Bottom Plug 980' with 70 Sacks 50-50 Poz 6% Gel

2nd Plug 320' with 20 Sacks

Top Plug Solid Bridge 40' with 10 Sacks

5 Sacks Rathole

5 Sacks Mouse Hole Plugged down at 7:30 AM Sun Cementing Co.

(If additional description is necessary, use BACK of this sheet)

Name of Plugging Contractor Blue Goose Drilling Co., Inc.


STATE OF KANSAS COUNTY OF BARTON, ss.

George E. Miller, Jr. (employee of owner) or (owner or operator) of the above-described well, being first duly sworn on oath, says: That I have knowledge of the facts, statements, and matters herein contained and the log of the above-described well as filed and that the same are true and correct. So help me God.

(Signature) George E. Miller
P.O. Box 1413, Great Bend, KS 67530
(Address)

SUBSCRIBED AND SWORN TO before me this 20th day of March, 1981

Helen C. Standley Notary Public.
My commission expires 12-8-83

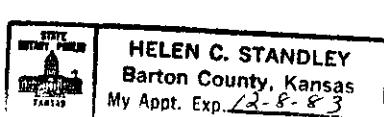

MAR 25 1981
3-25-81
KANSAS CORPORATION COMMISSION
WICHITA, KANSAS

1510120516-0000

WELL LOG

1 WATERSON TRUST
NW SE NW Sec 8-18S-29W

LANE COUNTY, KS

NAME OF OPERATOR: Mull Drilling Company Inc.
221 North Main Suite 300
Wichita, KS 67202


DATE COMPLETED: March 20, 1981

<u>FROM</u>	<u>TO</u>	
0	2195	Sand and Shale
2195	2221	Anhydrite
2221	3480	Sand and Shale
3480	4625	Lime and Shale
4625		T.D.

STATE OF KANSAS



COUNTY OF BARTON ss

George E. Miller, Jr., President of Blue Goose Drilling Co., Inc. being first duly sworn on oath says: That I have knowledge of the facts, statements and matters herein contained and the log of the above described well as filed and that the same are true and correct.

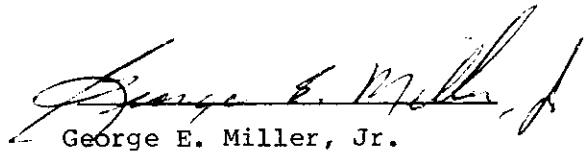


George E. Miller, Jr.

Subscribed and sworn before me this 23rd Day of March 1981.

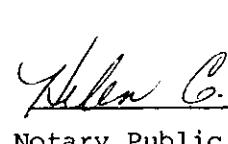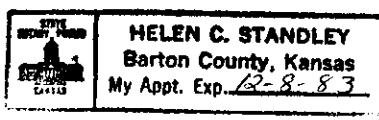

Helen C. Standley
Notary Public

My Commission Expires: 12-8-83

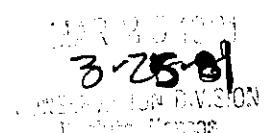

Notary Public
Helen C. Standley
Barton County, Kansas
My Appt. Exp. 12-8-83