


STATE OF KANSAS
STATE CORPORATION COMMISSION

15-101-20488-0000

WELL PLUGGING RECORD

Give All Information Completely
Make Required Affidavit
Mail or Deliver Report to
Conservation Division
State Corporation Comm.
245 North Water
Wichita, KS 67202

Lane _____ County. Sec. 13 Twp. 18S Rge. 29 E/W
Location as "NE/CNW 1/4 SW 1/4" or footage from lines _____
1310' FNL 350' FWL of NE/2
Lease Owner Wildcat Enterprises
Lease Name BARTLETT Well No. 1
Office Address P.O. Box 2, Dighton, Kansas
Character of Well (Completed as Oil, Gas or Dry Hole) _____
Dry Hole

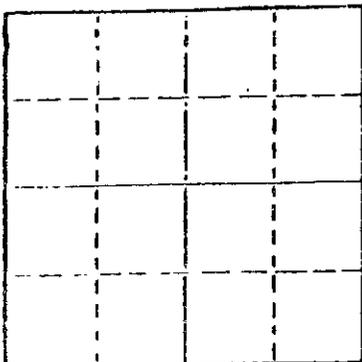

Locate well correctly on above Section Plat

Date Well completed 10-27 19 80
Application for plugging filed 10-27 19 80
Application for plugging approved 10-27 19 80
Plugging commenced 10-27 19 80
Plugging completed 10-27 19 80
Reason for abandonment of well or producing formation _____
No commercial quantity of gas or oil available
If a producing well is abandoned, date of last production _____
19

Was permission obtained from the Conservation Division or its agents before plugging was commenced? Yes

Name of Conservation Agent who supervised plugging of this well Gilbert Balthazar
Producing formation _____ Depth to top _____ Bottom _____ Total Depth of Well 4635'
Show depth and thickness of all water, oil and gas formations.

OIL, GAS OR WATER RECORDS

CASING RECORD

FORMATION	CONTENT	FROM	TO	SIZE	PUT IN	PULLED OUT

Describe in detail the manner in which the well was plugged, indicating where the mud fluid was placed and the method or methods used in introducing it into the hold. If cement or other plugs were used, state the character of same and depth placed, from _____ feet to _____ feet for each plug set.

T.D. 4635'
Set 1st plug @ 780' with 70 sx.
2nd plug @ 340' with 20 sx.
3rd plug @ 40' solid bridge with 10 sx.
Rathole with 5 sx., 50/50 posmix, 6% gel.
Plug was down @ 5:15 p.m. 10-27-80

RECEIVED
STATE CORPORATION COMMISSION
11-5-80
NOV - 5 1980

CONSERVATION DIVISION
Wichita, Kansas

(If additional description is necessary, use BACK of this sheet)

Name of Plugging Contractor Abercrombie Drilling, Inc.


STATE OF Kansas COUNTY OF Sedgwick, ss.
Jack L. Partridge, Asst. Sec.-Treas. (employee of owner) or (owner or operator)
of the above-described well, being first duly sworn on oath, says: That I have knowledge of the facts, statements, and matters herein contained and the log of the above-described well as filed and that the same are true and correct. So help me God.

(Signature) Jack L. Partridge
801 Union Center, Wichita, Kansas
(Address)

SUBSCRIBED AND SWORN TO before me this 31st day of October, 1980

Jeanette A. Metheny
Jeanette A. Metheny (Notary Public.)

My commission expires 08-18-84

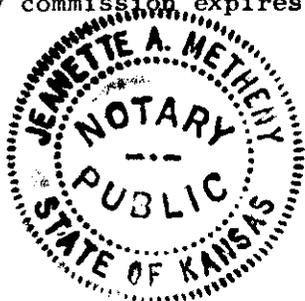

CONTRACTOR'S WELL LOG

15101-20488-0000

OPERATOR: Wildcat Enterprises
 CONTRACTOR: Abercrombie Drilling, Inc.
 WELL NAME: BARTLETT #1
 LOCATION: 1310' FNL 350' FWL of NE/2
 Sec. 13-18S-29W, Lane County, KS
 SPUD DATE: 10-17-80
 COMPLETION DATE: 10-27-80

0	362	Surface Sand & Shale
362	817	Sand & Blue Shale
817	1614	Sand & Shale
1614	1634	Shale
1634	1668	Anhydrite
1668	3160	Shale
3160	3312	Shale & Lime
3312	3379	Shale
3379	3410	Shale & Lime
3410	3638	Shale
3638	4020	Shale & Lime
4020	4308	Lime
4308	4512	Lime & Shale
4512	4586	Lime
4586	4535	Mississippian
	4535	Rotary Total Depth

Spud hole @ 6:30 p.m. 10-17-80. Drilled 362' of a 12-1/2" hole. Ran 9 joints of 8-5/8" 20# casing (tally 354.37') Set @ 359' K.B. Cemented with 225 sx. common, 2% gel, 3% c.c. Cement did circulate. Plug was down @ 3:00 a.m. 10-18-80.

RTD 4635'. Set 1st plug @ 780' with 70 sx., 2nd plug @ 340' with 20 sx., 3rd plug @ 40' solid bridge with 10 sx., rathole with 5 sx., 50/50 posmix, 6% gel. Plug was down @ 5:15 p.m. 10-27-80.

SAMPLE TOPS:

Anhydrite 1634'
 B/Anhydrite 1668'

RECEIVED
 STATE COMMISSION
 11-5-80
 NOV - 5 1980

CONSERVATION DIVISION
 Wichita, Kansas

STATE OF KANSAS)
) SS
 COUNTY OF SEDGWICK)

Jack L. Partridge, Assistant Secretary-Treasurer of Abercrombie Drilling, Inc., does hereby state that the above and foregoing is a true and correct copy of the log of the BARTLETT #1, 1310' FNL 350' FWL of NE/2, Section 13-18S-29W, Lane County, Kansas.

ABERCROMBIE DRILLING, INC.

BY: Jack L. Partridge
 Jack L. Partridge, Asst. Sec.-Treas



Subscribed and sworn to before me, a Notary Public, in and for the aforesaid county and state as of this 31st day of October, 1980.

Jeanette A. Metheny