

STATE OF KANSAS
STATE CORPORATION COMMISSION
200 Colorado Derby Building
Wichita, Kansas 67202

WELL PLUGGING RECORD
K.A.R.-82-3-117

API NUMBER 15-101-20387

LEASE NAME Reifschneider

WELL NUMBER "D" #1

SPOT LOCATION SE SW SE

SEC. 17 TWP. 18 RGE. 29 (E) or (W)

COUNTY Lane

Date Well Completed _____

Plugging Commenced 7-17-85

Plugging Completed 7-25-85

TYPE OR PRINT
NOTICE: Fill out completely
and return to Cons. Div.
office within 30 days.

LEASE OPERATOR Pickrell Drilling Company

ADDRESS 110 N. Market, Suite 205, Wichita, Ks. 67202

PHONE # (316-793-5742) OPERATORS LICENSE NO. 5123

Character of Well oil
(Oil, Gas, D&A, SWD, Input, Water Supply Well)

Did you notify the KCC/KDHE Joint District Office prior to plugging this well? Yes

Which KCC/KDHE Joint Office did you notify? District One

Is ACO-1 filed? _____ If not, is well log attached? With application

Producing formation _____ Depth to top _____ bottom _____ T.D. 4630'

Show depth and thickness of all water, oil and gas formations.

OIL, GAS OR WATER RECORDS | CASING RECORD

Formation	Content	From	To	Size	Put in	Pulled out
				8-5/8"	227'	None
				5-1/2"	4290'	533.57'

Describe in detail the manner in which the well was plugged, indicating where the mud fluid was placed and the method or methods used in introducing it into the hole. If cement or other plugs were used state, the character of same and depth placed, from feet to feet each set.

Dumped sand to 4080' and 5 sacks cement. Shot casing at 2500', 1100', 1000', 600' and 500'. Pulled 17 joints of 5-1/2" casing. Squeezed well with 2 sacks hulls 15 sacks gel, 50 sacks cement, 10 sacks gel, 1 sack hulls, released plug and pumped 150 sacks 60/40 pozmix cement with 6% added gel. Maximum pressure was 100 psi and zero shutin.

Name of Plugging Contractor Rockhold Engineering, Inc. License No. 5111
Address Box 698, Gt. Bend, Ks. 67530

STATE OF Kansas COUNTY OF Barton, ss.

James W. Rockhold (employee of operator) or (operator) of above-described well, being first duly sworn on oath, says: That I have knowledge of the facts, statements, and matters herein contained and the log of the above-described well as filed that the same are true and correct, so help me God.

(Signature) James W. Rockhold

(Address) Box 698, Gt. Bend, Ks. 67530

JUL 20 1985
7-29-85
WICHITA, KANSAS

SUBSCRIBED AND SWORN TO before me this 26th day of July, 1985

Iona M. Leatherman
Notary Public

My Commission expires: _____

IONA M. LEATHERMAN
Barton County, Kansas
My Appt. Exp. Feb 87

KANSAS DRILLERS LOG

API No. 15 — 101 — 20387-0000
County Number

S. 17 T. 18S R. 29W E
W

Loc. SE SW SE


Operator
PICKRELL DRILLING COMPANY

County Lane

Address
 205 LITWIN BLDG., WICHITA, KS. 67202

640 Acres
 N

Well No. 1 Lease Name REIFSCHNEIDER "D"

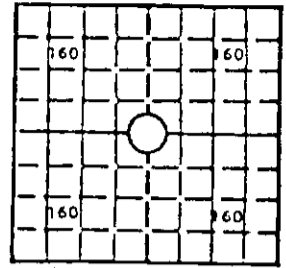

Locate well correctly

Elev.: Gr. 2821

Footage Location
feet from (N) (S) line feet from (E) (W) line

Principal Contractor **PICKRELL DRILLING COMPANY** Geologist **CLAUD L. SHEATS JR.**

Spud Date 6-04-79 Total Depth 4630 P.B.T.D.

Date Completed 7-10-79 Oil Purchaser **NCRA**

DF 2823 KB 2826

CASING RECORD

Report of all strings set — surface, intermediate, production, etc.

Purpose of string	Size hole drilled	Size casing set (in O.D.)	Weight lbs./ft.	Setting depth	Type cement	Sacks	Type and percent additives
Surf. casing		8 5/8"		227'		165sx.	
Prod. casing		5 1/2"		4290'		125sx.	

LINER RECORD

PERFORATION RECORD

Top, ft.	Bottom, ft.	Sacks cement	Shots per ft.	Size & type	Depth interval
			4	DP	4136-4141
TUBING RECORD			4	DP	4174-4178
Size	Setting depth	Packer set at			
2 3/8"	4242				

ACID, FRACTURE, SHOT, CEMENT SQUEEZE RECORD

Amount and kind of material used	Depth interval treated

INITIAL PRODUCTION

Date of first production <u>7-17-79</u>	Producing method (flowing, pumping, gas lift, etc.) <u>Pumping</u>				
RATE OF PRODUCTION PER 24 HOURS	Oil <u>131</u> bbls.	Gas <u>MCF</u>	Water <u>no water</u> bbls.	Gas-oil ratio	CFPB
Disposition of gas (vented, used on lease or sold)			Producing interval(s) <u>4136-4178</u>		

INSTRUCTIONS: As provided in KCC Rule 82-2-125, within 90 days after completion of a well, one completed copy of this Drillers Log shall be transmitted to the State Geological Survey of Kansas, 4150 Monroe Street, Wichita, Kansas 67209. Copies of this form are available from the Conservation Division, State Corporation Commission, 3830 So. Meridian (P.O. Box 17027), Wichita, Kansas 66217. Phone AC 316-522-2206. If confidential custody is desired, please note Rule 82-2-125. Drillers Logs will be an open file in the Oil and Gas Division, State Geological Survey of Kansas, Lawrence, Kansas 66044.

C-10-1972

RECEIVED
 STATE CORPORATION COMMISSION


APR 22 1985
422-85
 CONSERVATION DIVISION
 Wichita, Kansas

BAKER SERVICE TOOLS - TALLY PAD

New Completion Workover

Oil Company _____ Well No. 1 Field _____ Lease Reifschneider "D"
Company Man _____ Date Drilled June '79 County Lane State Kansas

15101-20387-0000

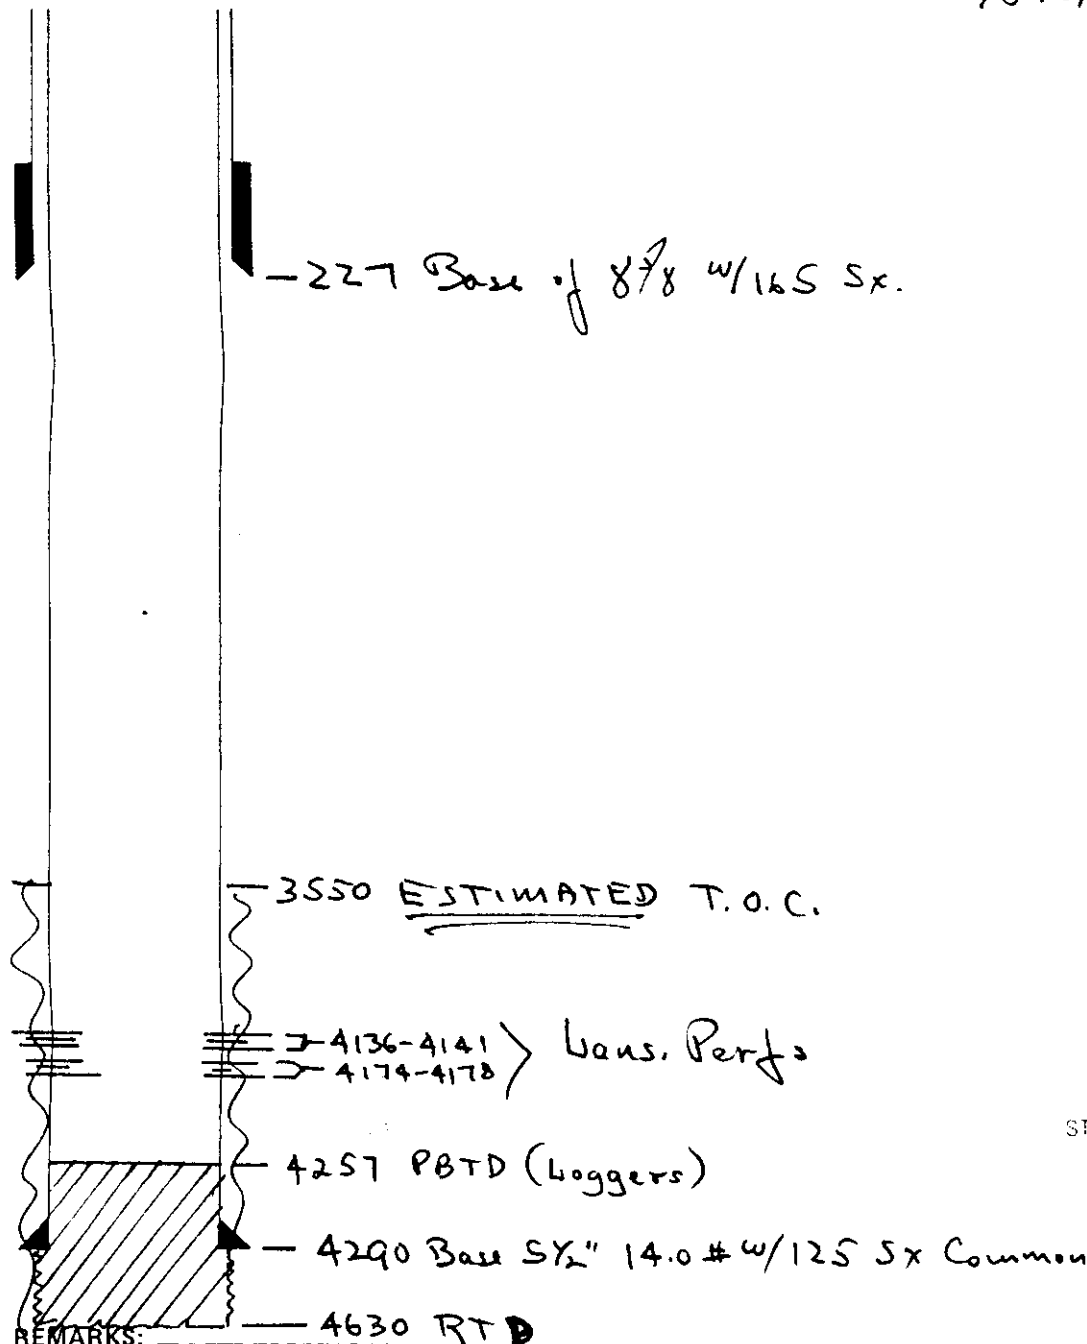

REMARKS:

RECEIVED
STATE CORPORATION COMMISSION

APR 22 1985
42285

CONSERVATION DIVISION
Wichita, Kansas

Date of Tally _____

No. Jts. on Location _____

Tbg. Sz. _____ Thd. _____ Wt. _____ Gr. _____

Csg. Sz. _____ Wt. _____ Gr. _____



A DIVISION OF BAKER OIL TOOLS, INC.