


STATE OF KANSAS
STATE CORPORATION COMMISSION

15-101-20426-0000

WELL PLUGGING RECORD

Give All Information Completely
Make Required Affidavit
Mail or Deliver Report to
Conservation Division
State Corporation Comm.
245 North Water
Wichita, KS 67202

LANE _____ County. Sec. 17 Twp. 18S Rge. 29W E/W
Location as "NE/CNW $\frac{1}{4}$ SW $\frac{1}{4}$ " or footage from lines _____
NW SE SE
Lease Owner PICKRELL DRILLING COMPANY
Lease Name REIFSCHNEIDER "D" #2 Well No. _____
Office Address 205 LITWIN BLDG., WICHITA, KS. 67202
Character of Well (Completed as Oil, Gas or Dry Hole) _____
Dry Hole

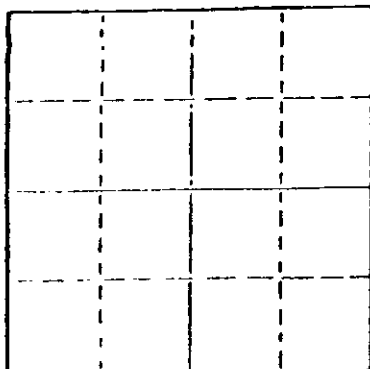

Locate well correctly on above
Section Plot

Date Well completed 12-20-79 19
Application for plugging filed 12-20-79 19
Application for plugging approved 12-20-79 19
Plugging commenced 12-20-79 19
Plugging completed 12-20-79 19
Reason for abandonment of well or producing formation _____
Dry Hole

If a producing well is abandoned, date of last production _____
19

Was permission obtained from the Conservation Division or
its agents before plugging was commenced? Yes

Name of Conservation Agent who supervised plugging of this well _____
Producing formation _____ Depth to top _____ Bottom _____ Total Depth of Well 4610
Show depth and thickness of all water, oil and gas formations.

OIL, GAS OR WATER RECORDS

CASING RECORD

FORMATION	CONTENT	FROM	TO	SIZE	PUT IN	PULLED OUT
				8 5/8	208	None

Describe in detail the manner in which the well was plugged, indicating where the mud fluid
was placed and the method or methods used in introducing it into the hold. If cement or other
plugs were used, state the character of same and depth placed, from _____ feet to
_____ feet for each plug set.

70sx at 850'
20sx. at 200'
10sx. at 40'
5 sm. in rathole Comp. 4:00AM 12-20-79

(If additional description is necessary, use BACK of this sheet)

Name of Plugging Contractor PICKRELL DRILLING COMPANY

STATE OF KANSAS COUNTY OF SEDGWICK, ss.
C. W. Sebitts (employee of owner) or (owner or operator)

of the above-described well, being first duly sworn on oath, says: That I have knowledge of
the facts, statements, and matters herein contained and the log of the above-described well
as filed and that the same are true and correct. So help me God. By: C. W. Sebitts

(Signature) *C. W. Sebitts*
205 LITWIN BLDG., WICHITA, KS. 67202
(Address)

SUBSCRIBED AND SWORN TO before me this 26 day of December, 19 79

My commission expires 2-18-80

Jo Ann Sarver
Notary Public.
Jo Ann Sarver



12-27-79

ROTARY DRILLING LOG

COMPANY: PICKRELL DRILLING COMPANY
 205 LITWIN BLDG.
 WICHITA, KS. 67202
 LOCATION: Reifschneider "D" #2
 NW SE SE Sec. 17-18S-29W
 Lane County, Kansas
 CONTRACTOR: **PICKRELL DRILLING COMPANY**
Wichita, Kansas

Rotary Drilling Commenced 12-7-79
 Rotary Drilling Completed 12-20-79

15-101-20426-0000

CASING RECORD: Surf.casing 8 5/8" set at 208' with 145sx. Comp. 5:55PM

LOG

(Figures indicate bottom of formation — measurements from top of rotary bushing.)

Shale - Top Soil	70	Lime & Shale	3815
Shale	212	Lime & Shale	3930
Shale	595	Lime & Shale	3995
Shale	1253	Lime	4050
Sand	1354	Lime	4080
Shale	1415	Lime & Shale	4150
Shale	1970	Lime	4165
Shale	2163	Lime	4170
Shale	2185	Lime	4200
Shale	2190	Lime & Shale	4265
Shale	2530	Lime & Shale	4330
Shale	2690	Lime & Shale	4385
Shale	2815	Lime & Shale	4435
Lime & Shale	2965	Lime	4450
Lime & Shale	3075	Lime	4480
Lime & Shale	3285	Lime & Shale	4530
Lime	3400	Lime	4560
Lime & Shale	3515	Lime	4565
Lime & Shale	3595	Lime	4607
Lime & Shale	3695	Lime	4610

RECEIVED
 DEC 27 1979
 12-27-79
 CONSERVATION DIVISION
 WICHITA, KANSAS

The undersigned, C. W. Sebitts, Attorney-in-Fact for PICKRELL DRILLING COMPANY, hereby certifies in behalf of said Company, that the above is a true and correct log of the formation encountered in drilling the above well as reflected by the Daily Drilling Reports.

PICKRELL DRILLING COMPANY
 By: [Signature]
 Attorney-in-Fact
 C. W. Sebitts

STATE OF KANSAS }
 COUNTY OF SEDGWICK } ss.:

On this 26 day of December, 1979, before me the undersigned, a Notary Public, in and for the County and State aforesaid, personally appeared C. W. Sebitts, to me known to be the identical person who subscribed the name of PICKRELL DRILLING COMPANY to the foregoing instrument as its Attorney-in-Fact and acknowledged to me that he executed the same as his free and voluntary act and deed, and as the free and voluntary act and deed of such company, for the uses and purposes therein set forth.

Given under my hand and seal of office the day and year last above written.

My commission expires: 2-18-80

[Signature]
 Notary Public
 Jo Ann Sarver

