

STATE OF KANSAS  
STATE CORPORATION COMMISSION

15-101-20521-0000

WELL PLUGGING RECORD

Give All Information Completely  
Make Required Affidavit  
Mail or Deliver Report to  
Conservation Division  
State Corporation Comm.  
245 North Water  
Wichita, KS 67202

Lane \_\_\_\_\_ County. Sec. 17 Twp. 18S Rge. 29W E/W  
Location as "NE/CNW/SW" or footage from lines \_\_\_\_\_  
SE SE NW


Lease Owner Pickrell Drilling Company  
Lease Name Reifschneider 'C' Well No. 1  
Office Address 110 N. Market, Suite 205, Wichita, KS 67202  
Character of Well (Completed as Oil, Gas or Dry Hole) \_\_\_\_\_  
Dry Hole

Date Well completed 3-18 1981  
Application for plugging filed 3-18 1981  
Application for plugging approved 3-18 1981  
Plugging commenced 3-18 1981  
Plugging completed 3-18 1981

Reason for abandonment of well or producing formation \_\_\_\_\_  
Dry Hole  
If a producing well is abandoned, date of last production \_\_\_\_\_  
19

Was permission obtained from the Conservation Division or its agents before plugging was commenced? Yes

Name of Conservation Agent who supervised plugging of this well Gil Balthazor  
Producing formation \_\_\_\_\_ Depth to top \_\_\_\_\_ Bottom \_\_\_\_\_ Total Depth of Well 4625  
Show depth and thickness of all water, oil and gas formations.

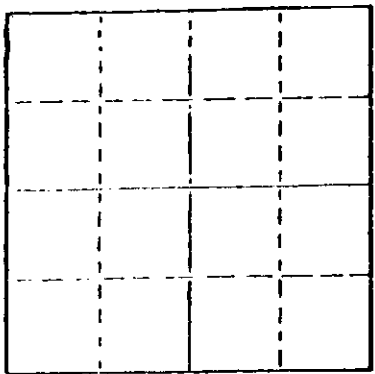

Locate well correctly on above Section Plat

OIL, GAS OR WATER RECORDS

CASING RECORD

FORMATION	CONTENT	FROM	TO	SIZE	PUT IN	PULLED OUT
				8 5/8"	206' KB	None

Describe in detail the manner in which the well was plugged, indicating where the mud fluid was placed and the method or methods used in introducing it into the hold. If cement or other plugs were used, state the character of same and depth placed, from \_\_\_\_\_ feet to \_\_\_\_\_ feet for each plug set.

- 60 sx at 840'
- 30 sx at 200'
- 20 sx at 40' with S/BP
- 5 sx rathole - completed 6:30 a.m. on 3-18-81

(If additional description is necessary, use BACK of this sheet)

Name of Plugging Contractor Pickrell Drilling Company

MAR 27 1981  
3-27-81  
STATE CORPORATION COMMISSION

STATE OF Kansas COUNTY OF Sedgwick, ss.  
C. W. Sebitts (employee of owner) or (owner or operator)

of the above-described well, being first duly sworn on oath, says: That I have knowledge of the facts, statements, and matters herein contained and the log of the above-described well as filed and that the same are true and correct. So help me God.

(Signature) [Signature]  
110 N. Market, Suite 205, Wichita, KS 67202  
(Address)

SUBSCRIBED AND SWORN TO before me this 25th day of March, 1981

My commission expires December 9, 1982

Jana Lea Schneweis  
Notary Public.

Jana Lea Schneweis

KANSAS

WELL COMPLETION REPORT AND DRILLER'S LOG

S. 17 T. 18S R. 29W E W

API No. 15 — 101 — 20,521 - 0000  
County Number

Loc. SE SE NW

County Lane

Operator  
Pickrell Drilling Company

Address  
110 N. Market, Suite 205, Wichita, Kansas 67202


Well No. Lease Name  
1 Reifschneider 'C'

Footage Location  
feet from (N) (S) line feet from (E) (W) line

Principal Contractor Geologist  
Pickrell Drilling Company Jay McNett  
Greg Issinghoff

Spud Date Date Completed Total Depth P.B.T.D.  
3-6-81 3-18-81 4625'

Directional Deviation Oil and/or Gas Purchaser

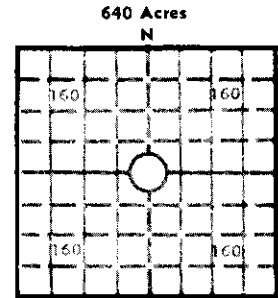

Locate well correctly  
Elev.: Gr. 2826'

DF 2828' KB 2831'

CASING RECORD

Report of all strings set—surface, intermediate, production, etc.

Purpose of string	Size hole drilled	Size casing set (in O.D.)	Weight lbs/ft.	Setting depth	Type cement	Sacks	Type and percent additives
		8 5/8"		206'	KB	140 sx	

LINER RECORD

PERFORATION RECORD

Top, ft.	Bottom, ft.	Sacks cement	Shots per ft.	Size & type	Depth interval

TUBING RECORD

Size	Setting depth	Packer set at

ACID, FRACTURE, SHOT, CEMENT SQUEEZE RECORD

Amount and kind of material used	Depth interval treated

INITIAL PRODUCTION


Date of first production Producing method (flowing, pumping, gas lift, etc.)

RATE OF PRODUCTION PER 24 HOURS  
Oil Gas Water Gas-oil ratio  
bbls. MCF bbls. CFPB

Disposition of gas (vented, used on lease or sold) Producing interval(s)

MAR 27 1981  
3-27-81  
CONSERVATION DIVISION  
Wichita, Kansas

INSTRUCTIONS: As provided in KCC Rule 82-2-125, within 90 days after completion of a well, one completed copy of this Drillers Log shall be transmitted to the State Geological Survey of Kansas, 4150 Monroe Street, Wichita, Kansas 67209. Copies of this form are available from the Conservation Division, State Corporation Commission, 245 No. Water, Wichita, Kansas 67202. Phone AC 316-522-2206. If confidential custody is desired, please note Rule 82-2-125. Drillers Logs will be on open file in the Oil and Gas Division, State Geological Survey of Kansas, Lawrence, Kansas 66044.

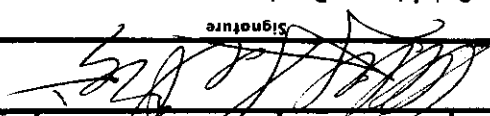Date Received	
Signature	
Title	C. W. Sebitts - Partner
Date	March 25, 1981

USE ADDITIONAL SHEETS, IF NECESSARY, TO COMPLETE WELL RECORD				
FORMATION DESCRIPTION, CONTENTS, ETC.	TOP	BOTTOM	NAME	DEPTH
DST #1, 4123-55 (Lsg) 30"-60"-60"-90" rec. 1' o11 & 700' SW, IFF 47#-147#, ISIP 1220#, FFP 210#-242#, FSIP 1220#. DST #2, 4168-90 (LKC) 30"-30"-30"-30" wk b d1ed - flushed tool wk b d1ed, rec. 20' SOCM, IFF 31#-31#, ISIP 47#, FFP 31#-39#, FSIP 47#. DST #3, 4272-4310, 30"-60"-60"-90" ("0" ring leaked resulting in a 150" flow followed by a 90" SI), rec. 60" GIP, 216' Gsy o11, 62' 0 & MCW (7% o11, 64% W, 29% M), 62' SO & MCW (5% o11, 79% W, 16% M), 134' VSO & MCW (2% o11, 96% W, 2% M), IFF 163#-358#, FSIP 561#. DST #4, 4573'-4595, 30"-30"-30"-30" wk b1ow rec. 30' thin dr1g mud, IFF 31#-31#, FFP 31#-47#, ISIP 1141#, FSIP 1125#.			Heebner Lans1ng Stark B/Kansas City Fort Scott Mississippi LTD	3914(-1083) 3960(-1129) 4238(-1407) 4360(-1529) 4481(-1650) 4568(-1737) 4625

Operator	Pickre11 Dr111ng Company
Well No.	1
Lease Name	Re1tschneider 'C'
s 17 T185 R 29W	
<b>WELL LOG</b> Show all important zones of porosity and contents thereof; cored intervals, and all drill-stem tests, in- cluding depth interval tested, cushion used, time tool open, flowing and shut-in pressures, and recoveries.	
SHOW GEOLOGICAL MARKERS, LOGS RUN, OR OTHER DESCRIPTIVE INFORMATION.	
DESIGNATE TYPE OF COMP.: OIL, GAS, DRY HOLE, SWD, ETC.	Dry Hole