


WELL PLUGGING RECORD

15101 20686-0000

Give All Information Completely
Make Required Affidavit

COUNTY _____ Lane _____ SEC. 7 TWP. 19S RGE. 27W N/W
Location as in quarters or footage from lines:
C SE NW

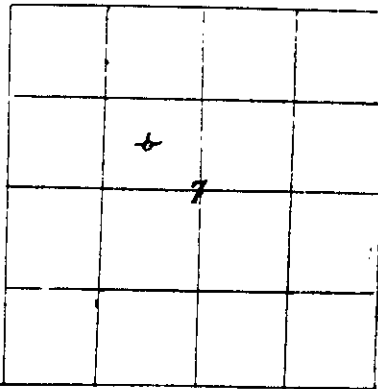

Locate Well
correctly on above
Section Platt.

Lease Owner DONALD C. SLAWSON
Lease Name BURMEISTER 'R' Well No. 1
Office Address 200 Douglas Building Wichita, Kansas 67202
Character of Well (Completed as Oil, Gas or Dry Hole): Dry Hole
Date Well Completed June 26, 1982
Application for plugging filed Yes
Plugging commenced June 26, 1982
Plugging completed June 26, 1982
Reason for abandonment of well or producing formation Dry Hole

Was permission obtained from the Conservation Division or it's
Agent's before plugging was commenced? Yes

Name of Conservation Agent who supervised plugging of this well Paul Luthi

Producing formation _____ Depth to top _____ bottom _____ T.D. 4702'

Show depth and thickness of all water, oil and gas formations.

OIL, GAS OR WATER RECORDS

Casing Record

Formation	Content	From	To	Size	Put in	Pulled Out
		surface	309'	8 5/8"		

Describe in detail the manner in which the well was plugged, indicating where the mud fluid was placed and the method or methods used in introducing it into the hold. If cement or other plugs were used, state the character of same and depth placed, from _____ feet to _____ feet for each plug set.

1st plug @ 1300' w/50 sx
2nd plug @ 350' w/40 sx
Bridge @ 40' w/10 sx
10 sx in Rat Hole


(If additional description is necessary, use BACK of this sheet)

Name of Plugging Contractor Halliburton Services
Box 579 Great Bend, Kansas 67530

STATE OF KANSAS COUNTY OF SEDGWICK, ss.
William R. Horigan (employee of owner) or (owner or operator) of the
above-described well, being first duly sworn on oath, says: That I have knowledge of the
facts, statements, and matters herein contained and the log of the above-described well as
filed and that the same are true and correct. So help me God.

(Signature)

William R. Horigan 200 Douglas Building
(Address) Wichita, KS 67202

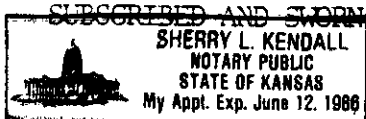

My Commission expires: 06/12/86

SUBSCRIBED AND SWORN TO before me this 17th day of October, 19 82

Sherry L. Kendall
Sherry L. Kendall

Notary Public

RECEIVED
STATE CORPORATION COMMISSION

OCT 28 1982
10-28-82
CONSERVATION DIVISION
Wichita, Kansas