

STATE OF KANSAS  
STATE CORPORATION COMMISSION

Give All Information Completely  
Make Required Affidavit  
Mail or Deliver Report to:  
Conservation Division  
State Corporation Commission  
211 No. Broadway  
Wichita, Kansas

WELL PLUGGING RECORD

Lane \_\_\_\_\_ County, Sec. 15 Twp. 19S Rge. \_\_\_\_\_ (E) 27(W)

Location as "NE/CNW%SW%" or footage from lines Ctr. NE SE

Lease Owner Graybol Oil Corporation

Lease Name Whipple Well No. 1

Office Address 2200 National Bank of Tulsa Bldg., Tulsa, Okla. 74103

Character of Well (completed as Oil, Gas or Dry Hole) Dry Hole

Date well completed October 24 19 64

Application for plugging filed October 24 19 64

Application for plugging approved October 24 19 64


Plugging commenced October 25 19 64

Plugging completed October 25 19 64

Reason for abandonment of well or producing formation Dry Hole

If a producing well is abandoned, date of last production \_\_\_\_\_ 19 \_\_\_\_\_

Was permission obtained from the Conservation Division or its agents before plugging was commenced? Yes

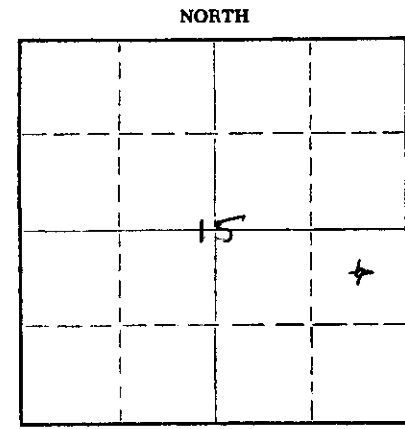

Locate well correctly on above Section Plat

Name of Conservation Agent who supervised plugging of this well W. L. Nichols, Moreland, Kansas

Producing formation None Depth to top \_\_\_\_\_ Bottom \_\_\_\_\_ Total Depth of Well 4700 Feet

Show depth and thickness of all water, oil and gas formations.

OIL, GAS OR WATER RECORDS

CASING RECORD

| FORMATION         | CONTENT     | FROM | TO   | SIZE   | PUT IN | PULLED OUT |
|-------------------|-------------|------|------|--------|--------|------------|
| Lansing Limestone | water       | 3994 | 4368 | 8 5/8" | 252'   | None       |
| Cherokee sand     | Impermeable | 4601 | 4625 |        |        |            |
| Mississippian     | water       | 4630 | 4700 |        |        |            |
|                   |             |      |      |        |        |            |
|                   |             |      |      |        |        |            |
|                   |             |      |      |        |        |            |

Describe in detail the manner in which the well was plugged, indicating where the mud fluid was placed and the method or methods used in introducing it into the hole. If cement or other plugs were used, state the character of same and depth placed, from \_\_\_\_\_ feet to \_\_\_\_\_ feet for each plug set.

Filled hole with heavy mud-laden fluid to 540'. Squeezed with 20 sacks of Portland cement through the drill pipe.  
Filled hole with heavy mud-laden fluid to 240'. Squeezed with 20 sacks of Portland cement through the drill pipe.  
Filled hole with heavy mud-laden fluid to 40'. Put in one quarter sack of hulls, then ten sacks of Portland cement through the drill pipe, filling hole to surface.

RECEIVED  
STATE CORPORATION COMMISSION

DEC 1 1964  
12-1-64  
CONSERVATION DIVISION  
Wichita, Kansas

(If additional description is necessary, use BACK of this sheet)

Name of Plugging Contractor None used

Address \_\_\_\_\_

STATE OF OKLAHOMA, COUNTY OF TULSA, ss.

Lyman C. Dennis (employee of owner) or (owner or operator) of the above-described well, being first duly sworn on oath, says: That I have knowledge of the facts, statements, and matters herein contained and the log of the above-described well as filed and that the same are true and correct. So help me God.

(Signature) Lyman C. Dennis

Tulsa, Oklahoma  
(Address)

SUBSCRIBED AND SWORN to before me this 30th day of November, 19 64

My commission expires October 2, 1967

[Signature]  
Notary Public.

15-101-00068-0000

GRAYBOL OIL CORPORATION

Lane County, Kansas

No. 1 Whipple

Ctr. NE SE Sec. 15-19S-27W

Contractor: Company Tools

Elev. 2658 D.F., 2652 G.L.

Commenced: November 8, 1964

Completed: November 24, 1964

Production: Dry and Abandoned

CASING RECORD

Set 8 5/8" casing at 252' with 165 sacks pozmix cement.

| <u>DEPTH</u> | <u>FORMATION</u>      | <u>WELEX ELECTROLOG TOPS:</u> |              |
|--------------|-----------------------|-------------------------------|--------------|
| 0-40         | Surface Clay and sand | Stone Corral anhydrite        | 1993 (+665)  |
| 40-50        | Sand                  | Heebner shale                 | 3951 (-1293) |
| 50-75        | Shale and post rock   | Toronto limestone             | 3969 (-1311) |
| 75-829       | Shale and shells      | Lansing limestone             | 3994 (-1336) |
| 829-1425     | Shale and gyp         | Base of Kansas City           | 4368 (-1710) |
| 1425-1495    | Shale and shells      | Marmaton limestone            | 4400 (-1742) |
| 1495-1725    | Sand and shale        | Fort Scott limestone          | 4522 (-1864) |
| 1725-1995    | Shale and shells      | Cherokees sandstone           | 4601 (-1943) |
| 1995-2025    | Anhydrite             | Mississippi formation         | 4630 (-1972) |
| 2025-2130    | Shale and shells      | Welex Total depth             | 4700         |
| 2130-2370    | Shale                 |                               |              |
| 2370-2535    | Shale and lime        | No drill stem tests taken.    |              |
| 2535-2827    | Lime and shale        |                               |              |
| 2827-2895    | Lime                  |                               |              |
| 2895-3185    | Lime and shale        |                               |              |
| 3185-3345    | Shale and lime        |                               |              |
| 3345-3490    | Lime and shale        |                               |              |
| 3490-3745    | Shale and lime        |                               |              |
| 3745-3865    | Lime and shale        |                               |              |
| 3865-4492    | Lime                  |                               |              |
| 4492-4552    | Lime and shale        |                               |              |
| 4552-4582    | Lime                  |                               |              |
| 4582-4612    | Lime and sand         |                               |              |
| 4612-4646    | Lime                  |                               |              |
| 4646-4694    | Cherty lime           |                               |              |
| 4694-4700    | Lime                  |                               |              |
| 4700         | Total depth           |                               |              |

**RECEIVED**  
 STATE CORPORATION COMMISSION  
 DEC 1 1964  
 12-1-64  
 CONSERVATION DIVISION  
 Wichita, Kansas

I hereby certify that the above is a true and correct log of the above-captioned well as taken directly from the daily drilling reports.

GRAYBOL OIL CORPORATION

BY: Lyman C. Dennis  
Lyman C. Dennis, Geologist

STATE OF OKLAHOMA

COUNTY OF TULSA

Subscribed and sworn to this 30th day of November, 1964.

My Commission expires: October 2, 1967

Notary Public  
NOTARY PUBLIC