


STATE OF KANSAS  
STATE CORPORATION COMMISSION

15-101-20875-0000

WELL PLUGGING RECORD

Give All Information Completely  
Make Required Affidavit  
Mail or Deliver Report to  
Conservation Division  
State Corporation Comm.  
245 North Water  
Wichita, KS 67202

Lane \_\_\_\_\_ County. Sec. 20 Twp. 18S Rge. 30 ~~XX~~/W  
Location as "NE/CNW 1/4 SW 1/4" or footage from lines \_\_\_\_\_  
NE SW NW  
Lease Owner MIDCO Exploration Inc. # 5254  
Lease Name Sweeney Well No. 1  
Office Address 411 Farmers & Bankers Bldg. Wichita, KS 67202  
Character of Well (Completed as Oil, Gas or Dry Hole) \_\_\_\_\_

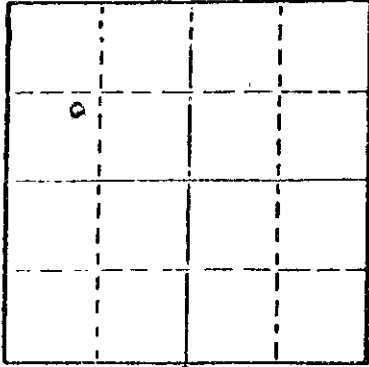

Locate well correctly on above  
Section Plat

DRY HOLE  
Date Well completed 2-13- 1984  
Application for plugging filed 2-13- 1984  
Application for plugging approved 2-13- 1984  
Plugging commenced 2-13- 1984  
Plugging completed 2-13- 1984  
Reason for abandonment of well or producing formation \_\_\_\_\_

DRY HOLE  
If a producing well is abandoned, date of last production 19 \_\_\_\_\_

Was permission obtained from the Conservation Division or its agents before plugging was commenced? YES

Name of Conservation Agent who supervised plugging of this well Richard Lacey  
Producing formation \_\_\_\_\_ Depth to top \_\_\_\_\_ Bottom \_\_\_\_\_ Total Depth of Well 4660'

Show depth and thickness of all water, oil and gas formations.

OIL, GAS OR WATER RECORDS

CASING RECORD

FORMATION	CONTENT	FROM	TO	SIZE	PUT IN	PULLED OUT
Surface		0	346'	8 5/8	344'	0

Describe in detail the manner in which the well was plugged, indicating where the mud fluid was placed and the method or methods used in introducing it into the hold. If cement or other plugs were used, state the character of same and depth placed, from \_\_\_\_\_ feet to \_\_\_\_\_ feet for each plug set.

4660' T.D. 165 Sacks 60-40 Posmix 2% Gel 3% cc  
1 st Plug @ 2200' with 50 Sacks  
2 nd Plug @ 1000' with 50 Sacks  
3 rd Plug @ 390' with 40 Sacks  
Solid Bridge @ 40' with 10 Sacks  
Rathole 15 Sacks  
Plug down 1:15 P.M. 2-13-84

(If additional description is necessary, use BACK of this sheet)

Name of Plugging Contractor Blue Goose Drilling Company Inc. # 5104


STATE OF KANSAS COUNTY OF BARTON, ss.  
George E. Miller, Jr. (agent for owner) or (owner or operator)  
of the above-described well, being first duly sworn on oath, says: That I have knowledge of the facts, statements, and matters herein contained and the log of the above-described well as filed and that the same are true and correct. So help me God.

(Signature) George E. Miller, Jr.  
P.O. Box 1413 Great Bend, KS 67530  
(Address)

SUBSCRIBED AND SWORN TO before me this 16th day of February, 19 84

My commission expires 12-8-87

Helen C. Standley  
Helen C. Standley Notary Public.

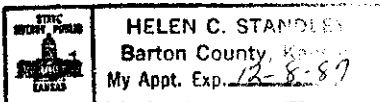

RECEIVED  
STATE CORPORATION COMMISSION  
MAR 30 1984  
3-30-84  
CONSERVATION DIVISION  
Wichita, Kansas