


STATE OF KANSAS
STATE CORPORATION COMMISSION

WELL PLUGGING RECORD

Give All Information Completely
Make Required Affidavit
Mail or Deliver Report to:
Conservation Division
State Corporation Commission
211 No. Broadway
Wichita, Kansas

Lane _____ County. Sec. 29 Twp. 18S Rge. 30W (E) _____ (W) _____
Location as "NE/CNW/SW" or footage from lines C NE NE SW
Lease Owner Thunderbird Drilling, Inc.
Lease Name Whiting Well No. 1
Office Address P. O. Box 18407- Wichita, Kansas 67218
Character of Well (completed as Oil, Gas or Dry Hole) Dry Hole
Date well completed 9/16/78 19_____
Application for plugging filed 9/16/78 19_____
Application for plugging approved 9/16/78 19_____
Plugging commenced 9/16/78 19_____
Plugging completed 9/16/78 19_____
Reason for abandonment of well or producing formation Dry Hole

NORTH

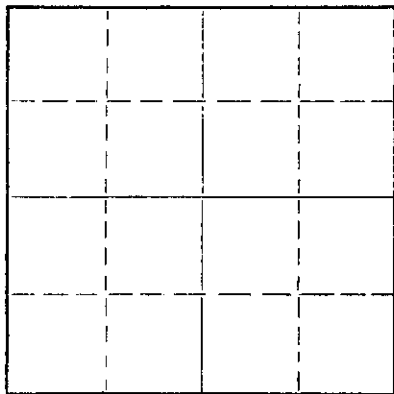

Locate well correctly on above Section Plat

If a producing well is abandoned, date of last production _____ 19_____
Was permission obtained from the Conservation Division or its agents before plugging was commenced? Yes

Name of Conservation Agent who supervised plugging of this well Gilbert Balthazor
Producing formation _____ Depth to top _____ Bottom _____ Total Depth of Well 4615 Feet
Show depth and thickness of all water, oil and gas formations.

OIL, GAS OR WATER RECORDS

CASING RECORD

FORMATION	CONTENT	FROM	TO	SIZE	PUT IN	PULLED OUT
				8 5/8"	336'	None

Describe in detail the manner in which the well was plugged, indicating where the mud fluid was placed and the method or methods used in introducing it into the hole. If cement or other plugs were used, state the character of same and depth placed, from _____ feet to _____ feet for each plug set.

1st plug @ 900' w/70 sx
2nd plug @ 300' w/20 sx
3rd plug @ 40' w/10 sx

RECEIVED
STATE CORPORATION COMMISSION

SEP 22 1978
9-22-78

CONSERVATION DIVISION
Wichita, Kansas

(If additional description is necessary, use BACK of this sheet)
Name of Plugging Contractor Thunderbird Drilling, Inc.
Address P. O. Box 18407- Wichita, Kansas 67218

STATE OF KANSAS COUNTY OF SEDGWICK, ss.
Burke Krueger

(employee of owner) or (owner or operator) of the above-described well, being first duly sworn on oath, says: That I have knowledge of the facts, statements, and matters herein contained and the log of the above-described well as filed and that the same are true and correct. So help me God.

(Signature) Burke Krueger

P. O. Box 18407- Wichita, Kansas 67218

(Address)

SUBSCRIBED AND SWORN TO before me this 20th day of September, 19 78

My commission expires 3-25-80

Gloria DeJesus

Notary Public.



DRILLERS LOG

15-101-20336-0000

Company Thunderbird Drilling, Inc.

Contractor Thunderbird Drilling, Inc.

Elevation 2895' K.B.

Farm Whiting

Well No. 1

Casing 8 5/8" @ 336' w/250 sx

Location C NE NE SW
Sec. 29-18S-30W

Production

County Lane County, Kansas

<u>From</u>	<u>To</u>	<u>Description</u>
0	336	Surface hole
336	1670	Shale
1670	1703	Blaine
1703	1758	Shale
1758	1975	Sand
1975	2008	Shale
2008	2236	Sand & Shale
2236	2280	Anhydrite
2280	2533	Shale & Shells
2533	3020	Shale & Lime
3020	3255	Lime & Shale
3255	3515	Shale & Lime
3515	3760	Lime
3760	3980	Shale & Lime
3980	4303	Lime
4303	4375	Lime & Shale
4375	4615	Lime
4615	R.T.D.	

STATE OF KANSAS
 COUNTY OF SEDGWICK
 9-22-78
 Notary Public

STATE OF KANSAS)
) ss.
 COUNTY OF SEDGWICK)

I, Burke Krueger, of Thunderbird Drilling, Inc. upon oath states that the above and foregoing is a true and correct copy from the Daily Drilling Report from your Whiting #1.

Burke Krueger

Subscribed and sworn to before me this 20th day of September, 1978.

Gloria DeJesus
 Notary Public

My commission expires: 3-25-80

