

CARD MUST BE TYPED

State of Kansas

CARD MUST BE SIGNED

NOTICE OF INTENTION TO DRILL

(see rules on reverse side)

Starting Date 2 18 86 month day year

API Number 15- 101-21,366-00-00
1770 FSL: 2110 FEL
SW NW SE Sec. 15 Twp. 17 S, Rg. 29W X West
1770 Ft. from South Line of Section
2110 Ft. from East Line of Section

OPERATOR: License # 6194
Name ESP DEVELOPMENT, INC.
Address RR #1, Box 18
City/State/Zip Paradise, Kansas 67658
Contact Person Bud Eulert
Phone 913-998-4413

(Note: Locate well on Section Plat on reverse side)
Nearest lease or unit boundary line 530 feet
County Lane
Lease Name Riley Well # 1

CONTRACTOR: License # 5302
Name Red Tiger Drilling Co.
City/State Wichita, Kansas 67202

Ground surface elevation feet MSL
Domestic well within 330 feet: yes X no
Municipal well within one mile: yes X no
Depth to bottom of fresh water 250-200 feet
Depth to bottom of usable water 1425 feet
Surface pipe by Alternate: 1 2 X

Well Drilled For: Well Class: Type Equipment:
X Oil SWD Infield X Mud Rotary
Gas Inj X Pool Ext Air Rotary
OWWO Expl Wildcat Cable

Surface pipe planned to be set 350 feet
Conductor pipe required N.A.
Projected Total Depth 4550 feet
ormation Mississippian

If OWWO: old well info as follows:
Operator
Well Name
Comp Date Old Total Depth

I certify that well will comply with K.S.A. 55-101, et seq., plus eventually plugging hole to KCC specifications.
Date 2-13-87 Signature of Operator or Agent Ray A. Ange Owner

For KCC Use:
Conductor Pipe Required 225 feet; Minimum Surface Pipe Required 225 feet per Alt. 402
This Authorization Expires 2-13-87 Approved By 2-13-87


Signature

Must be filed with the K.C.C. five (5) days prior to commencing well
 This card void if drilling not started within six (6) months of date received by K.C.C.

Important procedures to follow:

1. Notify District office before setting surface casing.
2. Set surface casing by circulating cement to the top.
3. File completion forms ACO-1 with K.C.C. within 90 days of well completion, following instructions on ACO-1, side 1, and including copies of wireline logs.
4. Notify District office 48 hours prior to old well workover or re-entry.
5. Prior to filing Intent, prepare a proposed plugging plan in case well is D & A, then obtain approval of plan when calling district office prior to setting surface pipe.
6. Submit plugging report (CP-4) to K.C.C. after plugging is completed.
7. Obtain an approved injection docket number before disposing of salt water.
8. Notify K.C.C. within 10 days when injection commences or terminates.

**A Regular Section of Land
 1 Mile = 5,280 Ft.**

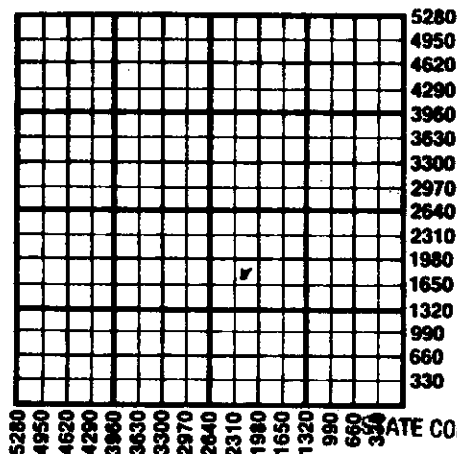

RECEIVED

STATE CORPORATION COMMISSION

alternate 2 completion, cement in the production pipe from below any usable water to surface within 120 days of spud date.

FEB 13 1987
 02-13-1987
 CONSERVATION DIVISION
 Wichita, Kansas

State Corporation Commission of Kansas
 Conservation Division
 200 Colorado Derby Building
 Wichita, Kansas 67202
 (316) 263-3238