

CARD MUST BE TYPED

State of Kansas
NOTICE OF INTENTION TO DRILL

CARD MUST BE SIGNED

(see rules on reverse side)

Starting Date: 5 16 85
month day year

API Number 15- **101-21,172-00-00**

OPERATOR: License # 5151
Name Gear Petroleum Co., Inc.
Address 300 Sutton Place
City/State/Zip Wichita, KS 67202
Contact Person Jim Thatcher
Phone 316-265-3351

NW NW NE Sec 15 Twp 17 S, Rge 29 East
(location) West

..... 4950 Ft North from Southeast Corner of Section
..... 2310 Ft West from Southeast Corner of Section
(Note: Locate well on Section Plat on reverse side)

CONTRACTOR: License # 5302
Name Red Tiger Drilling Company
City/State Wichita, KS 67202

Nearest lease or unit boundary line 330 feet.
County Lane
Lease Name Snider Well# 3-15

Domestic well within 330 feet : yes no
Municipal well within one mile : yes no

Well Drilled For: Well Class: Type Equipment:
 Oil Swd Infield Mud Rotary
 Gas Inj Pool Ext. Air Rotary
 OWWO Expl Wildcat Cable

Depth to Bottom of fresh water 200 feet
Lowest usable water formation Dakota
Depth to Bottom of usable water 1100 feet

If OWWO: old well info as follows:

Surface pipe by Alternate : 1 2 ** See other side**
Surface pipe to be set 320 feet

Operator
Well Name
Comp Date Old Total Depth
Projected Total Depth 4650 feet
Projected Formation at TD Mississippi
Expected Producing Formations LKC Cherokee

Conductor pipe if any required --- feet
Ground surface elevation unknown feet MSI.
This Authorization Expires 11-10-85
Approved By J. Thatcher
5-10-85

I certify that we will comply with K.S.A. 55-101, et seq., plus eventually plugging holes to K.C.C. specifications

Handwritten note: The 2" casing will be cemented from base of usable water to surface immediately
Production Engineer

Date 5-10-85 Signature of Operator or Agent Title

Handwritten: OK RCH

Must be filed with the K.C.C. five (5) days prior to commencing well
This card void if drilling not started within six (6) months of date received by K.C.C.

****Production casing will be cemented from base of usable water to surface immediately****

RECEIVED
STATE CORPORATION COMMISSION


Important procedures to follow:

A Regular Section of Land
1 Mile = 5,280 Ft.

MAY 10 1985

05-10-1985

CONSERVATION DIVISION
Wichita, Kansas

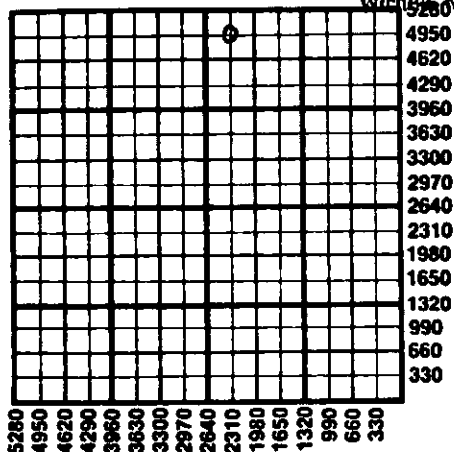

1. Notify District office before setting surface casing.
2. Set surface casing by circulating cement to the top.
3. File completion forms ACO-1 with K.C.C. within 90 days of well completion, following instructions on ACO-1, side 1, and including copies of wireline logs.
4. Notify District office 48 hours prior to old well workover or re-entry.
5. Prior to plugging, prepare a plugging plan, then obtain agreement from the appropriate district office for an approved plugging plan.
6. Submit plugging report (CP-4) to K.C.C. after plugging is completed.
7. Obtain an approved injection docket number before disposing of salt water.
8. Notify K.C.C. within 10 days when injection commences or terminates.
9. If an alternate 2 completion, cement in the production pipe from below any usable water to surface within 120 days of spud date.

State Corporation Commission of Kansas
Conservation Division
200 Colorado Derby Building
Wichita, Kansas 67202
(316) 263-3238