

CARD MUST BE TYPED



# NOTICE OF INTENTION TO DRILL

State of Kansas  
(see rules on reverse side)

CARD MUST BE SIGNED

Starting Date: 11-25-85  
month day year

API Number 15- 101-21,089-00-01

OPERATOR: License # 4661

Apex C. NE 1/4 Sec 15, Twp 17, S, Rge 29.  East  West

Name Galloway Petroleum Exploration, Inc.

Address 105 S. Broadway #300

City/State/Zip Wichita, KS 67202

Contact Person Casey Galloway

Phone (316) 267-7355

4180..... Ft North from Southeast Corner of Section

1230..... Ft West from Southeast Corner of Section

(Note: Locate well on Section Plat on reverse side)

CONTRACTOR: License # 5783

Name Galloway Drilling Co., Inc.

City/State Wichita, KS 67202

Nearest lease or unit boundary line 330..... feet.

County Lane

Lease Name Snider "A" Well# 1-15

Domestic well within 330 feet:  yes  no

Municipal well within one mile:  yes  no

Well Drilled For: Well Class: Type Equipment:

Oil  Swd  Infield  Mud Rotary

Gas  Inj  Pool Ext.  Air Rotary

OWWO  Expl  Wildcat  Cable

Depth to Bottom of fresh water 1000/150..... feet

Lowest usable water formation Dakota.....

Depth to Bottom of usable water 1000/1100..... feet

Surface pipe by Alternate: 1  2

Surface pipe ~~set~~ 346..... feet

Conductor pipe if any required none..... feet

Ground surface elevation 2788..... feet MSL.

If OWWO: old well info as follows:

This Authorization Expires 5-20-86

Approved By 11-20-85

Operator Gear Petroleum Co., Inc.

Well Name Fred 1-15

Comp Date 12-31-84 Old Total Depth 4640

Projected Total Depth 4640..... feet

Projected Formation at TD Mississippi

Expected Producing Formations Lansing

I certify that we will comply with K.S.A. 55-101, et seq., plus eventually plugging holes to K.C.C. specifications. Intent is to lead 3630 F&E 1300 F&E

Date 11-18-85 Signature of Operator or Agent


*Casey F. Galloway*  
Casey F. Galloway

Title President

Must be filed with the K.C.C. five (5) days prior to commencing well  
This card void if drilling not started within six (6) months of date received by K.C.C.

**Important procedures to follow:**

**A Regular Section of Land  
1 Mile = 5,280 Ft.**

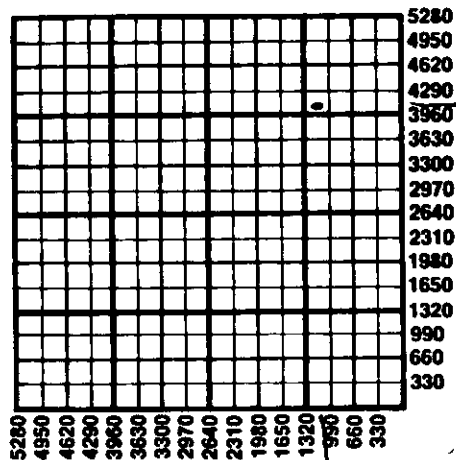

1. Notify District office before setting surface casing.
2. Set surface casing by circulating cement to the top.
3. File completion forms ACO-1 with K.C.C. within 90 days of well completion, following instructions on ACO-1, side I, and including copies of wireline logs.
4. Notify District office 48 hours prior to old well workover or re-entry.
5. Prior to plugging, prepare a plugging plan, then obtain agreement from the appropriate district office for an approved plugging plan.
6. Submit plugging report (CP-4) to K.C.C. after plugging is completed.
7. Obtain an approved injection docket number before disposing of salt water.
8. Notify K.C.C. within 10 days when injection commences or terminates.
9. If an alternate 2 completion, cement in the production pipe from below any usable water to surface within 120 days of spud date.

RECEIVED

STATE CORPORATION COMMISSION  
State Corporation Commission of Kansas  
Conservation Division

200 Colorado Derby Building  
Wichita, Kansas 67202  
(316) 263-3238

NOV 20 1985  
11-20-1985  
CONSERVATION DIVISION  
Wichita, Kansas