

CARD MUST BE TYPED

State of Kansas
NOTICE OF INTENTION TO DRILL
(see rules on reverse side)

CARD MUST BE SIGNED

Starting Date: 6 25 84
month day year

API Number 15- 101-20,993-00-00

OPERATOR: License # 5151
Name GEAR PETROLEUM CO., INC.
Address 300 Sutton Place
City/State/Zip Wichita, KS 67202
Contact Person Jim Thatcher
Phone 316-265-3351

..... SE. . NW. NW. Sec .15. Twp .17. S, Rge . 29. East
(location) West

..... 4290 Ft North from Southeast Corner of Section
..... 4290 Ft West from Southeast Corner of Section
(Note: Locate well on Section Plat on reverse side)

CONTRACTOR: License # 5302
Name Red Tiger Drilling Co.
City/State Wichita, KS 67202

Nearest lease or unit boundary line 990 feet.
County Lane
Lease Name .. Snider Well# 1-15

Domestic well within 330 feet : yes no
Municipal well within one mile : yes no

Well Drilled For: Well Class: Type Equipment:
 Oil Swd Infield Mud Rotary
 Gas Inj Pool Ext. Air Rotary
 OWWO Expl Wildcat Cable

Depth to Bottom of fresh water 200 feet
Lowest usable water formation Dakota
Depth to Bottom of usable water 1100 feet

If OWWO: old well info as follows:

Surface pipe by Alternate : 1 2
Surface pipe to be set 320 feet
Conductor pipe if any required none feet
Ground surface elevation 2798 feet MSI.
This Authorization Expires 12-15-84
Approved By 6-15-84 *[Signature]*

Operator
Well Name
Comp Date Old Total Depth

Projected Total Depth 4600 feet
Projected Formation at TD Mississippi
Expected Producing Formations Marmaton

I certify that we will comply with K.S.A. 55-101, et seq., plus eventually plugging hole to K.C.C. specifications.


Date 6/12/84 Signature of Operator or Agent

[Signature] Title Production Engineer.....
MHC/KOHE 6-15-84

Must be filed with the K.C.C. five (5) days prior to commencing well
 This card void if drilling not started within six (6) months of date received by K.C.C.

Important procedures to follow :

**A Regular Section of Land
 1 Mile = 5,280 Ft.**

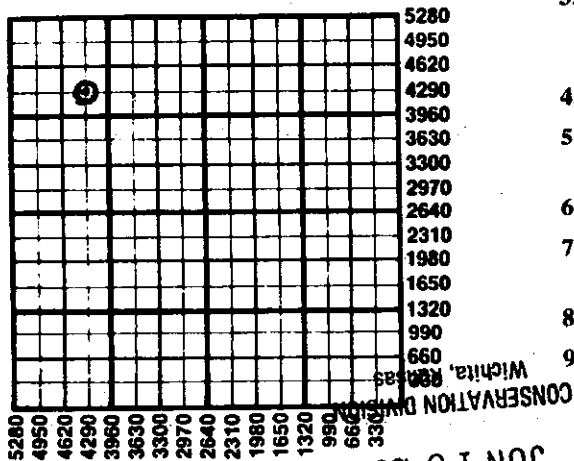

1. Notify District office before setting surface casing.
2. Set surface casing by circulating cement to the top.
3. File completion forms ACO-1 with K.C.C. within 90 days of well completion, following instructions on ACO-1, side 1, and including copies of wireline logs.
4. Notify District office 48 hours prior to old well workover or re-entry.
5. Prior to plugging, prepare a plugging plan, then obtain agreement from the appropriate district office for an approved plugging plan.
6. Submit plugging report (CP-4) to K.C.C. after plugging is completed.
7. Obtain an approved injection docket number before disposing of salt water.
8. Notify K.C.C. within 10 days when injection commences or terminates.
9. If an alternate 2 completion, cement in the production pipe from below any usable water to surface within 120 days of spud date.

RECEIVED
 STATE CORPORATION COMMISSION
 JUN 15 1984
 4891-5190

State Corporation Commission of Kansas
 Conservation Division
 200 Colorado Derby Building
 Wichita, Kansas 67202
 (316) 263-3238