

CARD MUST BE TYPED

State of Kansas
NOTICE OF INTENTION TO DRILL

CARD MUST BE SIGNED

(see rules on reverse side)

Starting Date: 1 24 85
month day year

API Number 15-101-21, 122-0000

OPERATOR: License # 5420
Name White & Ellis Drilling, Inc.
Address 401 E. Douglas - Suite 500
City/State/Zip Wichita, Ks. 67202
Contact Person Mike Dixon
Phone (316) 263-1102

SE NW SW Sec 10 Twp 17 S, Rge 29 East
(location) West

1650' Ft North from Southeast Corner of Section
4290' Ft West from Southeast Corner of Section
(Note: Locate well on Section Plat on reverse side)

CONTRACTOR: License # 5420
Name White & Ellis Drilling, Inc.
City/State Wichita, Ks. 67202

Nearest lease or unit boundary line 330 feet.
County Lane
Lease Name Snider Well# 1

Well Drilled For: Well Class: Type Equipment:
 Oil Swd Infield Mud Rotary
 Gas Inj Pool Ext. Air Rotary
 OWWO Expl Wildcat Cable

Domestic well within 330 feet: yes no
Municipal well within one mile: yes no

If OWWO: old well info as follows:

Operator
Well Name
Comp Date Old Total Depth
Projected Total Depth 4650 feet
Projected Formation at TD Mississippian
Expected Producing Formations Lansing/Kansas City

Depth to Bottom of fresh water 200 feet
Lowest usable water formation DAKOTA
Depth to Bottom of usable water 200 1100 feet
Surface pipe by Alternate: 1 2
Surface pipe to be set 350 feet
Conductor pipe if any required None feet
Ground surface elevation 2807 feet MSL
This Authorization Expires 7-18-85
Approved By R.H./K.C.C. 1-18-85

I certify that we will comply with K.S.A. 55-101, et seq., plus eventually plugging hole to K.C.C. specifications.

Date 1-18-85 Signature of Operator *Ernest Sifford* Title Sec.-Treas. of White & Ellis
Ernest Sifford

MHC/KCCE 1-18-85


Must be filed with the K.C.C. five (5) days prior to commencing well
 This card void if drilling not started within six (6) months of date received by K.C.C.

CONSERVATION DIVISION
 WICHITA, KANSAS

RECEIVED
 STATE CORPORATION COMMISSION
 1 Mile
 8861 8 JAN 18 1985
 01-18-1985

Important procedures to follow:

1. Notify District office before setting surface casing.
2. Set surface casing by circulating cement to the top.
3. File completion forms ACO-1 with K.C.C. within 90 days of well completion, following instructions on ACO-1, side 1, and including copies of wireline logs.
4. Notify District office 48 hours prior to old well workover or re-entry.
5. Prior to plugging, prepare a plugging plan, then obtain agreement from the appropriate district office for an approved plugging plan.
6. Submit plugging report (CP-4) to K.C.C. after plugging is completed.
7. Obtain an approved injection docket number before disposing of salt water.
8. Notify K.C.C. within 10 days when injection commences or terminates.
9. If an alternate 2 completion, cement in the production pipe from below any usable water to surface within 120 days of spud date.

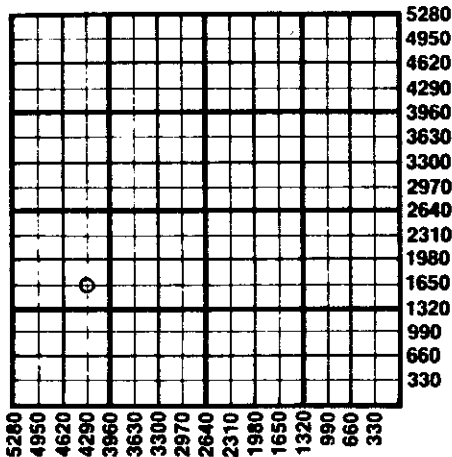

State Corporation Commission of Kansas
 Conservation Division
 200 Colorado Derby Building
 Wichita, Kansas 67202
 (316) 263-3238