

CARD MUST BE TYPED

State of Kansas
NOTICE OF INTENTION TO DRILL

CARD MUST BE SIGNED

(see rules on reverse side)

March 22, 1985

Starting Date:
month day year 1:45

OPERATOR: License # 5181
Name Donald C. Slawson
Address 200 Douglas Bldg.
City/State/Zip Wichita, Kansas 67202
Contact Person Bill Horigan
Phone (316)263-3201

CONTRACTOR: License # 5657
Name Slawson Drilling
City/State Wichita, Kansas

Well Drilled For: Well Class: Type Equipment:
 Oil Swd Infield Mud Rotary
 Gas Inj Pool Ext. Air Rotary
 OWWO Expl Wildcat Cable

If OWWO: old well info as follows:

Operator
Well Name
Comp Date Old Total Depth
Projected Total Depth 4600 feet
Projected Formation at TD Miss
Expected Producing Formations Lans., Marw., Cher.

API Number 15- 101-21,150-00-00
C S/2 NE Sec 5 Twp 17S 29W East
(location) S, Rge West

3300
1320 Ft North from Southeast Corner of Section
Ft West from Southeast Corner of Section
(Note: Locate well on Section Plat on reverse side)

Nearest lease or unit boundary line 660 feet.
County Lane
Lease Name Buchanan 'F' Well# 1

Domestic well within 330 feet: yes no
Municipal well within one mile: yes no

Depth to Bottom of fresh water 25 165 m HC feet
Lowest usable water formation Dakota
Depth to Bottom of usable water 1100 feet
-Surface pipe by Alternate: 1 2
-Surface pipe to be set 320 feet
-Conductor pipe if any required feet
Ground surface elevation 2816 feet MSL
This Authorization Expires 9-21-85
Approved By 3-21-85 R

I certify that we will comply with K.S.A. 55-101, et seq., plus eventually plugging hole to K.C.C. specifications.

Date March 20, 1985
Signature of Operator or Agent


Eldon S. West III Title

Mgr./Geologist

mhc/KOHE 3-21-85 Form C-1 4/84

NOISSIAID NOILMAKISNO
Wichita, Kansas
DIVISION

Must be filed with the K.C.C. five (5) days prior to commencing well
Discard void if drilling not started within six (6) months of date received by K.C.C.


MAR 21 1985

03-21-1985

STATE CORPORATION COMMISSION
A Regular Section of Land
1 Mile = 5,280 Ft.

Important procedures to follow:

1. Notify District office before setting surface casing.
2. Set surface casing by circulating cement to the top.
3. File completion forms ACO-1 with K.C.C. within 90 days of well completion, following instructions on ACO-1, side 1, and including copies of wireline logs.
4. Notify District office 48 hours prior to old well workover or re-entry.
5. Prior to plugging, prepare a plugging plan, then obtain agreement from the appropriate district office for an approved plugging plan.
6. Submit plugging report (CP-4) to K.C.C. after plugging is completed.
7. Obtain an approved injection docket number before disposing of salt water.
8. Notify K.C.C. within 10 days when injection commences or terminates.
- *9. If an alternate 2 completion, cement in the production pipe from below any usable water to surface within 120 days of spud date.

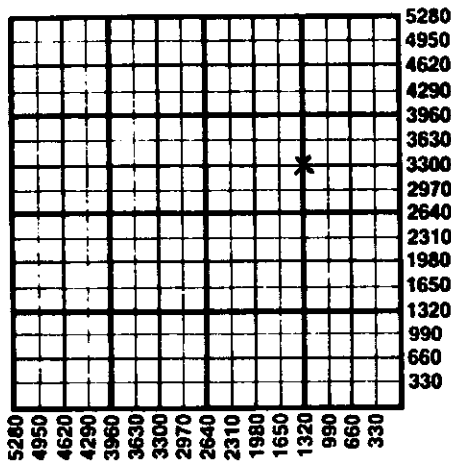

*Circulate alternative cementing material per

State Corporation Commission of Kansas
Conservation Division

200 Colorado Derby Building
82-3-106(b)4. Wichita, Kansas 67202
(316) 263-3238