


1510120914-0000

WELL PLUGGING RECORD

Give All Information Completely  
 Make Required Affidavit

COUNTY Lane SEC. 12 TWP. 17S RGE. 29 W  
 Location as in quarters or footage from lines:  
SW SE SE 12-17S-29W

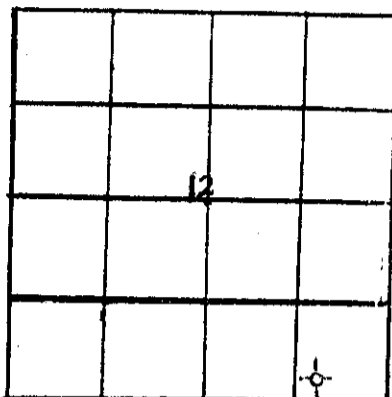

Locate Well  
 correctly on above  
 Section Platt.

Lease Owner Chief Drilling Co., Inc.  
 Lease Name Eaton "U" Well No. #1  
 Office Address 905 Century Plaza, Wichita, Ks. 67202  
 Character of Well (Completed as Oil, Gas or Dry Hole): D.H.  
 Date Well Completed 1-17-84  
 Application for plugging filed 1-17-84  
 Plugging commenced 1-17-84  
 Plugging completed 1-17-84  
 Reason for abandonment of well or producing formation \_\_\_\_\_

Was permission obtained from the Conservation Division or it's  
 Agent's before plugging was commenced? yes

Name of Conservation Agent who supervised plugging of this well Bob Tarbutton  
 Producing formation \_\_\_\_\_ Depth to top \_\_\_\_\_ bottom \_\_\_\_\_ T.D. 4630

Show depth and thickness of all water, oil and gas formations.

OIL, GAS OR WATER RECORDS

Casing Record

Formation	Content	From	To	Size	Put in	Pulled Out
Surface	8 5/8" 321'	new	20# 8	jts. set	@ 330'	

Describe in detail the manner in which the well was plugged, indicating where the mud  
 fluid was placed and the method or methods used in introducing it into the hold. If cement  
 or other plugs were used, state the character of same and depth placed, from \_\_\_\_\_ feet  
 to \_\_\_\_\_ feet for each plug set.

Plugged w/50 sx. @ 2180', 50 sx. @ 1710'.  
 50 sx. @ 1080', 40 sx. @ 390', 10 sx. @ 40'  
 w/solid bridge, 15 sx. circulated in the rat hole,  
 10 sx. circulated in mouse hole, Total 225 sx.  
 60-40 pos mix, 2% gel, 3% c.c., started @ 4:30  
 p.m completed @ 7:00 p.m. Bob Tarbutton State  
 Plugger

(If additional description is necessary, use BACK of this sheet)

Name of Plugging Contractor Warrior Drilling Co., Rig #2

STATE OF Kansas COUNTY OF Sedgwick, ss.  
F.W. Shelton, Jr., Vice Pres. (employee of owner) or ~~owner or operator~~ of the  
 above-described well, being first duly sworn on oath, says: That I have knowledge of the  
 facts, statements, and matters herein contained and the log of the above-described well as  
 filed and that ~~the same~~ they are true and correct. So help me God.

(Signature) F.W. Shelton, Jr.  
 F.W. SHELTON, JR., VICE PRES.  
 (Address)

905 Century Plaza, Wichita, Ks.

JAN 27 1984  
 01-27-1984  
 CONSERVATION DIVISION  
 Wichita, Kansas  
 SUBSCRIBED AND SWORN TO before me this 17th day of January, 19 84

MARTHA E. GUSTIN  
 NOTARY PUBLIC  
 STATE OF KANSAS  
 MY APPT. EXPIRES 7-15-85

Martha E. Gustin  
 Martha E. Gustin  
 Notary Public.

My Commission expires: