


WELL PLUGGING RECORD

Give All Information Completely
Make Required Affidavit
Mail or Deliver Report to:
Conservation Division
State Corporation Commission
211 No. Broadway
Wichita, Kansas

McPherson County, Sec. 29 Twp. 16 Rge. 1 (E) (W)

Location as "NE/CNW/SW" or footage from lines NW SW SW
Lease Owner Dick Hess, et al
Lease Name Karber
Office Address 800 E. Hancock, McPherson, Kansas
Character of Well (completed as Oil, Gas or Dry Hole) Dry Hole
Date well completed June 10, 1962
Application for plugging filed June 10, 1962
Application for plugging approved 19
Plugging commenced June 10, 1962
Plugging completed June 10, 1962
Reason for abandonment of well or producing formation

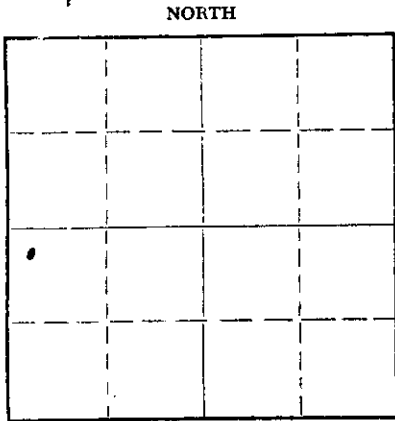

Locate well correctly on above Section Plat

If a producing well is abandoned, date of last production 19
Was permit obtained from the Conservation Division or its agents before plugging was commenced? Yes

Name of Conservation Agent who supervised plugging of this well Gilbert J. Toman
Producing formation None Depth to top Bottom Total Depth of Well 2708 Feet
Show depth and thickness of all water, oil and gas formations.

OIL, GAS OR WATER RECORDS

CASING RECORD

FORMATION	CONTENT	FROM	TO	SIZE	PUT IN	PULLED OUT
No Water Sand except	Shale & Shells	0	130	8 5/8	132'	None
Water Sand		25'	35'			

Describe in detail the manner in which the well was plugged, indicating where the mud fluid was placed and the method or methods used in introducing it into the hole. If cement or other plugs were used, state the character of same and depth placed, from feet to feet for each plug set.

Plugged hole at 120 ft. with 20 sacks cement. Top plug set at 35 ft. with 8 sacks cement. 2 sacks in rathole.....

RECEIVED
STATE CORPORATION COMMISSION
JUL 3 1962
CONSERVATION DIVISION
Wichita, Kansas

(If additional description is necessary, use BACK of this sheet)

Name of Plugging Contractor Blackstone Drilling, Inc.
Address Box # 455, McPherson, Kansas

STATE OF Kansas, COUNTY OF McPherson, ss.
Operator (employee of owner) or (owner or operator) of the above-described

well, being first duly sworn on oath, says: That I have knowledge of the facts, statements, and matters herein contained and the log of the above-described well as filed and that the same are true and correct. So help me God.

(Signature) Dick Hess
Dick Hess
800 East Hancock, McPherson, Kansas (Address)

SUBSCRIBED AND SWORN TO before me this 28 day of June, 1962

My commission expires August 20, 1963 Notary Public.



15169-00699-0000


Blackstone Drilling, Inc.

P. O. BOX 455 • PHONE CH-1-1250
McPHERSON • KANSAS

June 11, 1962

COMPANY: DICK HESS, ET AL
CONTRACTOR: BLACKSTONE DRILLING, INC.
FARM: KARBERT # 1
LOCATION: NW 24 Sec. 24, T29N-R14W,
Saline County, Kansas
COMMENCED: May 30, 1962
COMPLETED: June 10, 1962
ELEVATION: 1336 - Estimated

0	to	130	Shale & Shells
130	to	700	Line
700	to	2063	Shale & Line
2063	to	2183	K. C. Line
2183	to	2300	Line
2300	to	2675	Shale & Line
2675	to	2700	Shale & Sand
2700	to	2700	Miss Chert
			T. D.


TOPS: Kansas City - 2063'

Mississippi - 2700'

Measurements taken from K. B.

RECEIVED
STATE CORPORATION COMMISSION

JUL 3 1962

CONSERVATION DIVISION
Wichita, Kansas

CERTIFICATE

I, H. J. Plouffe, President of Blackstone Drilling, Inc., do hereby certify that the above and foregoing is a true and correct copy of log on the Karbert # 1, located on Sec. 24-16-14, Saline County, Kansas as reflected by files of the Blackstone Drilling, Inc.


H. J. Plouffe, President

Subscribed and sworn to before me a Notary Public, within and for McPherson County, Kansas this 11th day of June, 1962.


Ruth McVay, Notary Public

My Commission Expires: 12/18/65