


WELL PLUGGING RECORD

Give All Information Completely
Make Neat and Accurate
Mail or Deliver Report to:
Conservation Division
State Corporation Commission
200 Kansas Building
Wichita, Kansas

NORTH

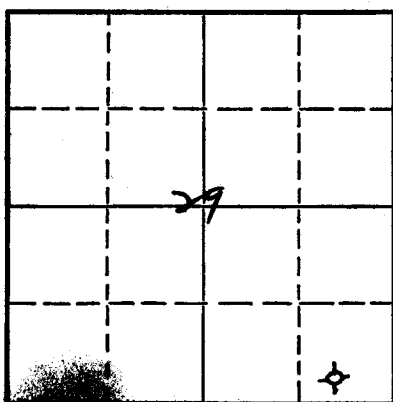

Saline County. Sec. 29 Twp. 16 Rge. 1 XX (W)
Location as "NE/CNW/SW" or footage from lines C, S/2 SE SE/4
Lease Owner E. K. Carey Drilling Co., Inc.
Lease Name M. F. & J. Karber Well No. 1
Office Address Box 620, McPherson, Kansas
Character of Well (completed as Oil, Gas or Dry Hole) Dry Hole
Date well completed November 8, 1952
Application for plugging filed December 6, 1952
Application for plugging approved 8, 1952
Plugging commenced 9, 1952
Plugging completed 12, 1952
Reason for abandonment of well or producing formation Non Commercial

If a producing well is abandoned, date of last production _____ 19____
Was permission obtained from the Conservation Division or its agents before plugging was commenced? Yes

Name of Conservation Agent who supervised plugging of this well Ruel Durkee
Producing formation Miss. Chat Depth to top 2616 Bottom _____ Total Depth of Well 2660 Feet
Show depth and thickness of all water, oil and gas formations.

OIL, GAS OR WATER RECORDS

CASING RECORD

Formation	Content	From	To	Size	Put In	Pulled Out
Miss. Chat	Water with	2616	2660	8-5/8	120	None
	show oil			5-1/2	2621	2328'

Describe in detail the manner in which the well was plugged, indicating where the mud fluid was placed and the method or methods used in introducing it into the hole. If cement or other plugs were used, state the character of same and depth placed, from _____ feet to _____ feet for each plug set.

Filled with crushed rock from 2660 back up to 2610. Dumped 6 sacks cement 2610 to 2570. Filled with mud 2570 to 130'. Filled with rock 130 to 115'. Ran 15 sacks cement 115 to 85'. Filled with mud 85 to 20' and capped with 5 sacks cement to cellar floor.

RECEIVED
STATE CORPORATION COMMISSION

DEC 20 1952

CONSERVATION DIVISION
Wichita, Kansas

(If additional description is necessary, use BACK of this sheet)

Correspondence regarding this well should be addressed to E. K. Carey Drlg. Co. Att: Herbert Rhoton
Address Box 620, McPherson, Kansas

STATE OF Kansas, COUNTY OF McPherson, ss.
Herbert Rhoton (employee of owner) or (owner or operator) of the above-described well,
being first duly sworn on oath, says: That I have knowledge of the facts, statements, and matters herein contained and the log of the above-described well as filed and that the same are true and correct. So help me God.

(Signature) Herbert Rhoton
Box 620, McPherson, Kansas
(Address)

SUBSCRIBED AND SWORN to before me this 19th day of December, 1952.

My commission expires November 13, 1956 _____ Notary Public.

PLUGGING
WELL SEC. 29 T. 16 R. 1
BOX 620, McPHERSON, KS

WELL PLUGGING RECORD

Give All Information Completely
Make Required Affidavit
Mail or Deliver Report to:
Conservation Division
State Corporation Commission
800 Biting Building
Wichita, Kansas

Saline County, Sec. 29 Twp. 16 Rge. 1 (W)

Location as "NE/CNW $\frac{1}{4}$ SW $\frac{1}{4}$ " or footage from lines C, S/2 SE SE/4

Lease Owner E. K. Carey Drilling Co., Inc.

Lease Name M. F. & J. Karber Well No. 1

Office Address Box 620, McPherson, Kansas

Character of Well (completed as Oil, Gas or Dry Hole) Dry Hole

Date well completed November 8, 19 52

Application for plugging filed December 6, 19 52

Application for plugging approved " 8, 19 52

Plugging commenced " 9, 19 52

Plugging completed " 12, 19 52

Reason for abandonment of well or producing formation Non Commercial

If a producing well is abandoned, date of last production 19

Was permission obtained from the Conservation Division or its agents before plugging was commenced? Yes

Name of Conservation Agent who supervised plugging of this well Ruel Durkee

Producing formation Miss. Chat Depth to top 2616 Bottom Total Depth of Well 2660 Feet

Show depth and thickness of all water, oil and gas formations.

OIL, GAS OR WATER RECORDS

CASING RECORD

Formation	Content	From	To	Size	Put In	Pulled Out
Miss. Chat	Water with show oil	2616	2660	8-5/8	120	None
				5-1/2	2621	2328'

Describe in detail the manner in which the well was plugged, indicating where the mud fluid was placed and the method or methods used in introducing it into the hole. If cement or other plugs were used, state the character of same and depth placed, from feet to feet for each plug set.

Filled with crushed rock from 2660 back up to 2610. Dumped 6 sacks cement 2610 to 2570. Filled with mud 2570 to 130'. Filled with rock 130 to 115'. Ran 15 sacks cement 115 to 85'. Filled with mud 85 to 20' and capped with 5 sacks cement to cellar floor.

RECEIVED
CONSERVATION DIVISION
DECEMBER 11 1952
CONSERVATION DIVISION
WICHITA, KANSAS

(If additional description is necessary, use BACK of this sheet)

Correspondence regarding this well should be addressed to E. K. Carey Drlg. Co. Att: Herbert Rhoton
Address Box 620, McPherson, Kansas

STATE OF Kansas, COUNTY OF McPherson, ss.

Herbert Rhoton (employee of owner) or (owner or operator) of the above-described well, being first duly sworn on oath, says: That I have knowledge of the facts, statements, and matters herein contained and the log of the above-described well as filed and that the same are true and correct. So help me God.

(Signature) Herbert Rhoton

Box 620, McPherson, Kansas

(Address)

SUBSCRIBED AND SWORN TO before me this 19th day of December, 19 52.

My commission expires November 13, 1956

23-5091-s 8-50-10M

Notary Public.

PLUGGING
FILE SEC 29 T 16 R 19
BOOK PAGE 65 LINE 44

ROTARY DRILLER'S LOG

15-169-00737-0000

E. K. Carey Drilling Company Inc., - Operator
 Box 620
 McPherson, Kansas

1291 K. B.
 Elevation: 1277 D..F.
 1275 Gr.

Mike Karber #1

8-5/8" x 5 1/2" Head 6.55'
 below K. B.

C, 3/2 SE/4 SE/4
 Sec. 29-16-1W
 Saline County, Kansas

Casing Record:

8-5/8" Csg. 120' W/85 sx.
 5-1/2" Csg. 2681' W/50 sx.

Well Commenced: 10-13-52
 Well Completed: 10-22-52

Contractor: E. K. Carey, Contractor (Rig #2) Box 620, McPherson, Kansas
 Geologist: Don Hollar, E. K. Carey Drilg. Co., 815 Central Bldg. Wichita

Figures Indicate Bottom of Formation K. B.

Cellar	7
Shale	30
Shale & shells	119
Anhydrite	240
Lime & shale	695
Shale & lime	735
Lime & shale	820
Shale & shells	1555
Lime & shale	1898
Shale & lime	1998
Lime	2000
Lime K. C.	2070
Lime	2302
Lime & shale	2390
Shale & lime	2555
Shale	2616
Lime (Miss)	2626 TD

Geologist Tops:

Lansing	2008
Mississippi	2616 (-1335)

Rotary Total Depth 2625

Set 5 1/2" casing 2621' or 4' off bottom.

DST - 2618-25, 7' anchor. Recovered 35' mud 75% water cut and 7' of oil. Water not salty. Tool open 90 min, 15 min RHP 645%.

The above Rotary Driller's Log is complete and correct to the best of my knowledge.

RECEIVED

COMMISSION

E. K. CAREY CONTRACTOR

DIVISION

By

Herbert Rhoton
 Herbert Rhoton, Superintendent

SUBSCRIBED AND SWORN to before me this 19 day of December, 1952

C. Schuyler
 NP

My Commission Expires November 13, 1956

PLUGGING
 FILE SEC 29-16-1W
 BOOK PAGE 65 LINE 44