


SP

Give All Information Completely
Make Required Affidavit
Mail or Deliver Report to:
Conservation Division
State Corporation Commission
212 No. Market
Wichita, Kansas

WELL PLUGGING RECORD

Saline County, Sec. 29 Twp. 16 Rge. (E) 1 (W)
Location as "NE/CNWxSWx" or footage from lines. NE SE NE
Lease Owner Melland Drilling Co., Inc.
Lease Name Karber-Smith Well No. 2
Office Address Box 783 McPherson, Kansas 67460
Character of Well (completed as Oil, Gas or Dry Hole) dry hole
Date well completed August 7 19 67
Application for plugging filed August 7 19 67
Application for plugging approved August 7 19 67
Plugging commenced August 7 19 67
Plugging completed August 7 19 67
Reason for abandonment of well or producing formation dry hole

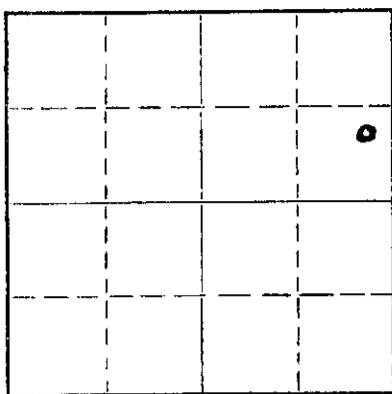

Locate well correctly on above Section Plat

If a producing well is abandoned, date of last production 19
Was permission obtained from the Conservation Division or its agents before plugging was commenced? yes

Name of Conservation Agent who supervised plugging of this well Herman Justice
Producing formation Depth to top Bottom Total Depth of Well 2647 Feet
Show depth and thickness of all water, oil and gas formations.

OIL, GAS OR WATER RECORDS

CASING RECORD

FORMATION	CONTENT	FROM	TO	SIZE	PUT IN	PULLED OUT
				8 5/8"	113'	None

Describe in detail the manner in which the well was plugged, indicating where the mud fluid was placed and the method or methods used in introducing it into the hole. If cement or other plugs were used, state the character of same and depth placed, from feet to feet for each plug set.

Filled hole from 2647' to 110' with heavy mud
Set plug at 110'
Put 20 sacks of cement on plug
Filled hole to 40' with mud
Set plug at 40'
Put 10 sacks of cement on plug

2 sacks of cement in rathole

RECEIVED
AUG 21 1967
CONSERVATION DIVISION
Wichita, Kansas

(If additional description is necessary, use BACK of this sheet)

Name of Plugging Contractor Melland Drilling Co., Inc.
Address Box 783 McPherson, Kansas 67460

STATE OF Kansas, COUNTY OF McPherson, ss.
Donald J. Melland (employee of owner) or (owner or operator) of the above-described well, being first duly sworn on oath, says: That I have knowledge of the facts, statements, and matters herein contained and the log of the above-described well as filed and that the same are true and correct. So help me God.

(Signature) Donald J. Melland
Box 783 McPherson, Kansas
(Address)

SUBSCRIBED AND SWORN TO before me this 9th day of August, 1967

Frederic B. Melland
Notary Public.

My commission expires December 23, 1967

15169 20008 0000

WELL RECORD

LEASE: Karber-Smith

WELL NO. 2

ELEVATION:

LOCATION: NE SE NE
Sec. 29-16-1W

COMMENCED: 8/2/67

COMPLETED: 8/7/67

OPERATOR: Melland Drlg. Co., Inc.

CONTRACTOR: Melland Drilling Company, Inc
Post Office Box 783
McPherson, Kansas

CASING RECORD: 8 5/8" @ 113' / 90' sx

FORMATION	LOG	FORMATION	LOG
surface clay	44		
shale & shells	113		
anhydrite	245		
shale & lime	815		
lime & shale	1885		
lime, sand, shale	2066		
lime & shale	2347		
shale & lime	2647		
RTD	2647		


RECEIVED
STATE CORPORATION COMMISSION
APR 12 1968
CONSERVATION DIVISION
Wichita, Kansas

CERTIFICATE

State of Kansas, County of McPherson, ss.

I, Donald J. Melland, do hereby certify that the above is a true and correct copy of the log of the above named and described well, as reflected by the records of the Melland Drilling Company, Inc.

Donald J. Melland

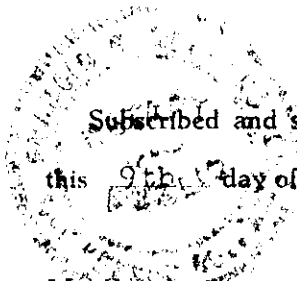

Subscribed and sworn to before me, a Notary Public, in and for the County of McPherson, State of Kansas, this 9th day of August, 1967.

My Commission expires: December 23, 1967

John B. Dill
_____ Notary Public