


15.169.20196.0000

WELL PLUGGING RECORD

Give All Information Completely
 Make Required Affidavit

COUNTY Saline SEC. 29 TWP. 16S RGE. 1W W
 Location as in quarters or footage from lines:
NE/4 of SW/4 of NW/4 of NE/4 on 2185' FEL & 955' FN 40'

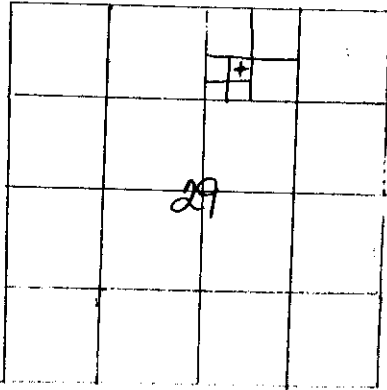

Locate Well
 correctly on above
 Section Plat.

Lease Owner Alta, Inc.
 Lease Name KARBER Well No. 1-29 or "2"
 Office Address P.O. Box 11245, Wichita, KS 67211
 Character of Well (Completed as Oil, Gas or Dry Hole): dry hole
 Date Well Completed 12/03/82
 Application for plugging filed 12/03/82
 Plugging commenced 12/03/82
 Plugging completed 12/03/82
 Reason for abandonment of well or producing formation dry hole

Was permission obtained from the Conservation Division or it's
 Agent's before plugging was commenced? yes

Name of Conservation Agent who supervised plugging of this well Gilbert Toman
 Producing formation D & A Depth to top bottom T.D. 3416'
 Show depth and thickness of all water, oil and gas formations.

OIL, GAS OR WATER RECORDS

Casing Record

| Formation | Content | From | To | Size | Put in | Pulled Out |
|-----------|---------|------|-----|--------|--------|------------|
| | | 0 | 200 | 8-5/8" | 200' | none |
| | | | | | | |
| | | | | | | |

Describe in detail the manner in which the well was plugged, indicating where the mud
 fluid was placed and the method or methods used in introducing it into the hold. If cement
 or other plugs were used, state the character of same and depth placed, from feet
 to feet for each plug set.

50 sks @ 200'
10 sks @ 40'
10 sks in rathole
50/50 poz., 2% cc
by Sun

(If additional description is necessary, use BACK of this sheet)

Name of Plugging Contractor Allen Drilling Company

STATE OF KANSAS COUNTY OF BARTON, ss.
Dale L. Smith (employee of owner) or (~~owner or operator~~) of the
 above-described well, being first duly sworn on oath, says: That I have knowledge of the
 facts, statements, and matters herein contained and the log of the above-described well as
 filed and that the same are true and correct. So help me God.

(Signature) Dale L. Smith
P.O. Box 1389, Gt. Bend, KS
 (Address)

SUBSCRIBED AND SWORN TO before me this 8th day of December, 19 82



My Commission expires:

RECEIVED
 Notary Public
 DEC 17 1982
 CONSERVATION DIVISION
 Wichita, Kansas