


Give All Information Completely
Make Required Affidavit
Mail or Deliver Report to:
Conservation Division
State Corporation Commission
212 No. Market
Wichita, Kansas

WELL PLUGGING RECORD

NORTH

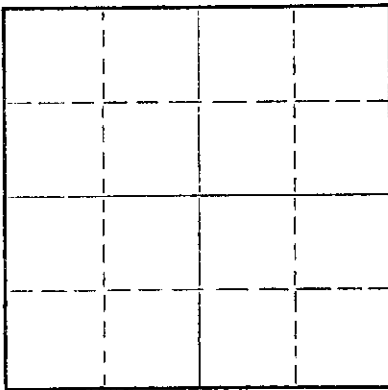

Locate well correctly on above
Section Plat

Saline County. Sec. 29 Twp. 16 Rge. I W. (E) (W)
Location as "NE/CNW/SW" or footage from lines N/2 N/W N/E
Lease Owner Charles Gould
Lease Name Karber Well No. I
Office Address 5828 North Broadway Wichita, Kansas
Character of Well (completed as Oil, Gas or Dry Hole) oil
Date well completed IO-31 19 67
Application for plugging filed Nov 19 67
Application for plugging approved Nov 19 67
Plugging commenced II-22 19 67
Plugging completed II-28 19 67
Reason for abandonment of well or producing formation

If a producing well is abandoned, date of last production 19
Was permission obtained from the Conservation Division or its agents before plugging was commenced? Yes

Name of Conservation Agent who supervised plugging of this well Gilbert Toman
Producing formation Depth to top Bottom Total Depth of Well 2660' Feet
Show depth and thickness of all water, oil and gas formations.

OIL, GAS OR WATER RECORDS

CASING RECORD

FORMATION	CONTENT	FROM	TO	SIZE	PUT IN	PULLED OUT
				5 1/2"		2,321'

Describe in detail the manner in which the well was plugged, indicating where the mud fluid was placed and the method or methods used in introducing it into the hole. If cement or other plugs were used, state the character of same and depth placed, from feet to feet for each plug set.

Plugged off bottom of hole with sand. Sand from 2652 1/2' to 2600'. Dumped 5 sx of cement. Mudded hole to 160'. Made 10' of rock bridge. Dumped 25 sx of cement. Mudded hole to 40'. Made 10' of rock bridge. Dumped 10 sx of cement, filling to the bottom of the cellar.

RECEIVED
NOV 29 1967
CONSERVATION DIVISION
WICHITA, KANSAS

(If additional description is necessary, use BACK of this sheet)

Name of Plugging Contractor Art Lamb Casing Pulling Co.
Address 2809 King St. Hutchinson, Kansas

STATE OF Kansas, COUNTY OF Reno, ss.
Art Lamb (employee of owner) or (owner or operator) of the above-described well, being first duly sworn on oath, says: That I have knowledge of the facts, statements, and matters herein contained and the log of the above-described well as filed and that the same are true and correct. So help me God

(Signature) [Signature]
2809 King St. Hutchinson, Kansas
(Address)

SUBSCRIBED AND SWORN TO before me this 28 th day of November, 19 67

My commission expires Jan 5, 1970

[Signature] Notary Public.

WELL RECORD

LEASE: Karber #1
 WELL NO. :
 ELEVATION: 1294 RB
 LOCATION: N/2 NW NE
 Sec. 29-16-1W
 COMMENCED: 10/26/67
 COMPLETED: 10/31/67
 OPERATOR: Charles E. Gould
 CONTRACTOR: Melland Drilling Company, Inc
 Post Office Box 783
 McPherson, Kansas
 CASING RECORD: 8 5/8" @ 128' / 950x
 5 1/2" @ 2660' / 50gx

FORMATION	LOG	FORMATION	LOG
shale & shells	128		
lime & shale	363		
shale & lime	520		
lime & shale	950		
shale & lime	1060		
shale	1595		
shale & lime	1775		
lime & shale	2028		
Mississippi	2660		
PBD	2660		
Sample Tops			
Lansing	2010		
Mississippi	2660		

Ref. 2629 to 2639
 PBD 2652-1/2

RECEIVED
 STATE CERTIFICATION COMMISSION
 NOV 22 1967
 REGISTRATION DIVISION
 Topeka, Kansas

CERTIFICATE

State of Kansas, County of McPherson, ss.
 I, Donald J. Melland, do hereby certify that the above is a true and correct copy of the log of the above named and described well, as reflected by the records of the Melland Drilling Company, Inc.

Donald J. Melland

Subscribed and sworn to before me, a Notary Public, in and for the County of McPherson, State of Kansas, this 8th day of November, 1967.

My Commission expires: December 31, 1967

[Signature]
 Notary Public