


Give All Information Completely
Make Required Affidavit
Mail or Deliver Report to:
Conservation Division
State Corporation Commission
212 No. Market
Wichita, Kansas

WELL PLUGGING RECORD

Saline County. Sec. 29 Twp. 16S Rge. 1W (E) (W)
Location as "NE/CNW/SW" or footage from lines. NE/4
Lease Owner E.M. & S. Oil
Lease Name Henry Karber Well No. B-1
Office Address Box 316, Canton, Kansas 67428
Character of Well (completed as Oil, Gas or Dry Hole) Disposal
Date well completed April 1, 19 58
Application for plugging filed May 2, 19 67
Application for plugging approved May 4, 19 67
Plugging commenced May 5, 19 67
Plugging completed May 5, 19 67
Reason for abandonment of well or producing formation Not needed-Lease plugged.

NORTH

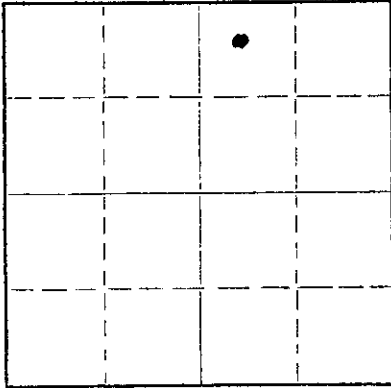

Locate well correctly on above
Section Plat

If a producing well is abandoned, date of last production _____ 19 ____
Was permission obtained from the Conservation Division or its agents before plugging was commenced? Yes

Name of Conservation Agent who supervised plugging of this well Gilbert Toman
Producing formation _____ Depth to top 526 Bottom _____ Total Depth of Well 570 Feet
Show depth and thickness of all water, oil and gas formations.

OIL, GAS OR WATER RECORDS

CASING RECORD

FORMATION	CONTENT	FROM	TO	SIZE	PUT IN	PULLED OUT
<u>Lime & Shale</u>	<u>Water</u>	<u>526'</u>	<u>570'</u>	<u>5 1/2"</u>	<u>526'</u>	<u>None</u>

Describe in detail the manner in which the well was plugged, indicating where the mud fluid was placed and the method or methods used in introducing it into the hole. If cement or other plugs were used, state the character of same and depth placed, from _____ feet to _____ feet for each plug set.

Flushed sand to bottom of hole with water. Filled casing to top with 2 yards of ready-mix cement.

RECEIVED
STATE CORPORATION COMMISSION
MAY 15 1967

CONSERVATION DIVISION
Wichita, Kansas

(If additional description is necessary, use BACK of this sheet)

Name of Plugging Contractor E.M. & S. Oil
Address Box 316 - Canton, Kansas 67428

STATE OF KANSAS, COUNTY OF MCPHERSON, ss.
Glenn E. Murray (employee of owner) or (owner or operator) of the above-described well, being first duly sworn on oath, says: That I have knowledge of the facts, statements, and matters herein contained and the log of the above-described well as filed and that the same are true and correct. So help me God.

(Signature) Glenn E. Murray
274109 Kansas
(Address)

SUBSCRIBED AND SWORN TO before me this MAY 13 1967 day of 19

My commission expires Feb 8th, 1970
Notary Public.











RECEIVED
STATE CORPORATION COMMISSION

MAY 3 1967

CONSERVATION DIVISION
Wichita, Kansas

