

TYPE

AFFIDAVIT OF COMPLETION FORM

ACO-1 WELL HISTORY

Compt. _____

SIDE ONE

Two (2) copies of this form shall be filed with the Kansas Corporation Commission, 200 Colorado Derby Building, Wichita, Kansas 67202, within thirty (30) days after the completion of a well, regardless of how the well was completed. Attach separate letter of request if the information is to be held confidential. If confidential, only file one copy. Information on Side One will be of public record and Side Two will then be held confidential.

Applications must be made on dual completion, commingling, salt water disposal, injection and temporarily abandoned wells.

Attach one copy only wireline logs (i.e. electrical log, sonic log, gamma ray neutron log, etc.). (Rules 82-2-105 & 82-2-125) KCC# (316) 263-3238.

LICENSE # 5181 EXPIRATION DATE 06/30/85

OPERATOR DONALD C. SLAWSON API NO. 15-101-20,972-0000

ADDRESS 200 Douglas Building COUNTY Lane

Wichita, Kansas 67202 FIELD

** CONTACT PERSON Sherry Kendall PROD. FORMATION

PHONE 316-263-3201

PURCHASER N/A LEASE Dodge 'C'

ADDRESS WELL NO. 1

DRILLING SLAWSON DRILLING CO., INC. #5657 WELL LOCATION W/2 SW SE

CONTRACTOR 200 Douglas Building 680 Ft. from South Line and

ADDRESS Wichita, Kansas 67202 2150 Ft. from East Line of

PLUGGING Halliburton Services the SE (Qtr.) SEC 6 TWP 17S RGE 29(W).

CONTRACTOR CONTRACTOR ADDRESS Box 579

ADDRESS Great Bend, KS 67530

TOTAL DEPTH 4653' PBTD

SPUD DATE April 24, 1984 DATE COMPLETED May 3, 1984

ELEV: GR 2829' DF 2832' KB 2835'


DRILLED WITH (CABLE) (ROTARY) (DR) TOOLS.

DOCKET NO. OF DISPOSAL OR REPRESSURING WELL BEING USED TO DISPOSE OF WATER FROM THIS LEASE

Amount of surface pipe set and cemented 450' DV Tool Used? No

THIS AFFIDAVIT APPLIES TO: (Circle ONE) - Oil, Gas, Shut-in Gas, Dry, Disposal, Injection, Temporarily Abandoned, OWWO. Other

ALL REQUIREMENTS OF THE STATUTES, RULES AND REGULATIONS PROMULGATED TO REGULATE THE OIL AND GAS INDUSTRY HAVE BEEN FULLY COMPLIED WITH.

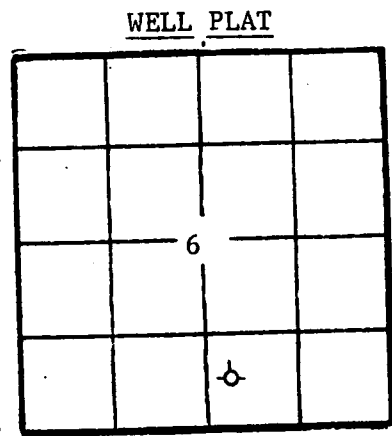

(Office Use Only) KCC KGS SWD/REP PLG

A F F I D A V I T


William R. Horigan, being of lawful age, hereby certifies that:

I am the Affiant, and I am familiar with the contents of the foregoing Affidavit. The statements and allegations contained therein are true and correct.

Signature of William R. Horigan

William R. Horigan (Name)

SUBSCRIBED AND SWORN TO BEFORE ME this 8th day of June, 1984.

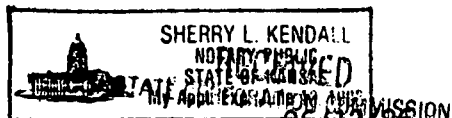

Signature of Sherry L. Kendall

Sherry L. Kendall (Notary Public)

MY COMMISSION EXPIRES: JUN 21 1984

** The person who can be reached by phone regarding any questions concerning this information. Wichita, Kansas