

TYPE

AFFIDAVIT OF COMPLETION FORM

ACO-1 WELL HISTORY

SIDE ONE

NP 88343

Compt. \_\_\_\_\_

Two (2) copies of this form shall be filed with the Kansas Corporation Commission, 200 Colorado Derby Building, Wichita, Kansas 67202, within thirty (30) days after the completion of a well, regardless of how the well was completed.

Attach separate letter of request if the information is to be held confidential. If confidential, only file one copy. Information on Side One will be of public record and Side Two will then be held confidential.

Applications must be made on dual completion, commingling, salt water disposal, injection and temporarily abandoned wells.

Attach one copy only wireline logs (i.e. electrical log, sonic log, gamma ray neutron log, etc.). (Rules 82-2-105 & 82-2-125) KCC# (316) 263-3238.

LICENSE # 5181 EXPIRATION DATE 06/30/83

OPERATOR DONALD C. SLAWSON API NO. 15-101-20,791-0000

ADDRESS 200 Douglas Building COUNTY Lane

Wichita, Kansas 67202 FIELD Wildcat SHAY 50

\*\* CONTACT PERSON Sherry Kendall PROD. FORMATION Marmaton

PHONE 316-263-3201 NP

PURCHASER Inland Crude Purch. Corp. LEASE YORK 'FF'

ADDRESS 200 Douglas Building WELL NO. 1

Wichita, Kansas 67202 WELL LOCATION C NE SW

DRILLING SLAWSON DRILLING CO., INC. 1880 Ft. from South Line and

CONTRACTOR 200 Douglas Building 1680 Ft. from West Line of

ADDRESS Wichita, Kansas 67202 the SW (Qtr.) SEC 6 TWP 17SRGE 29W(W).

PLUGGING N/A

CONTRACTOR ADDRESS

CONTRACTOR ADDRESS

TOTAL DEPTH 4640' PBDT 4571'

SPUD DATE April 25, 83 DATE COMPLETED May 19, 1983

ELEV: GR 2832 DF 2835 KB 2838


DRILLED WITH (CABLE) (ROTARY) (AKK) TOOLS.

DOCKET NO. OF DISPOSAL OR REPRESSURING WELL BEING USED TO DISPOSE OF WATER FROM THIS LEASE CD-10787

Amount of surface pipe set and cemented 468' DV Tool Used? No

THIS AFFIDAVIT APPLIES TO: (Circle ONE) - Oil, Gas, Shut-in Gas, Dry, Disposal, Injection, Temporarily Abandoned, OWWO. Other

ALL REQUIREMENTS OF THE STATUTES, RULES AND REGULATIONS PROMULGATED TO REGULATE THE OIL AND GAS INDUSTRY HAVE BEEN FULLY COMPLIED WITH.

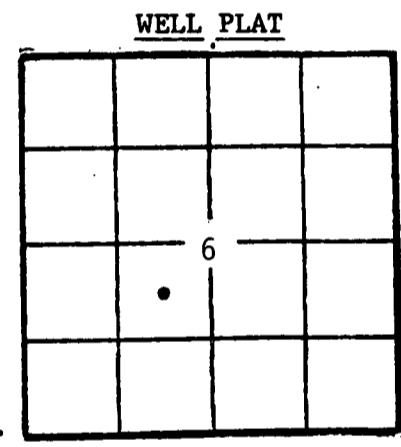

(Office Use Only) KCC [checked] KGS [checked] SWD/REP PLG.

A F F I D A V I T


William R. Horigan, being of lawful age, hereby certifies that:

I am the Affiant, and I am familiar with the contents of the foregoing Affidavit. The statements and allegations contained therein are true and correct.

Signature of William R. Horigan

William R. Horigan (Name) day of June 20th

SUBSCRIBED AND SWORN TO BEFORE ME this 20th day of June 19 83.

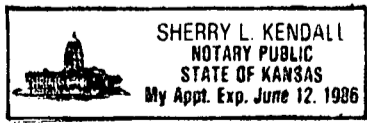

Signature of Sherry L. Kendall

(NOTARY PUBLIC) RECEIVED Sherry L. Kendall STATE CORPORATION COMMISSION

MY COMMISSION EXPIRES: 06/12/86

\*\* The person who can be reached by phone regarding any questions concerning this information.

CONSERVATION DIVISION Wichita, Kansas

7-7-83 JUL 07 1983