

STATE CORPORATION COMMISSION OF KANSAS
OIL & GAS CONSERVATION DIVISION

WELL COMPLETION OR RECOMPLETION FORM
ACO-1 WELL HISTORY

DESCRIPTION OF WELL AND LEASE

Operator: License # 5181
Name DONALD C. SLAWSON
Address 200 Douglas Building
City/State/Zip Wichita, Kansas 67202

Purchaser.....

Operator Contact Person Bill Horigan
Phone (316) 263-3201

Contractor: License # 5657
Name SLAWSON DRILLING CO., INC.

Wellsite Geologist Jeff Stewart
Phone (316) 263-3201

Designate Type of Completion

- New Well Re-Entry Workover
- Oil SWD Temp
- Gas Inj Delayed
- Dry Other (Core, Water Supply etc.)

If OWO: old well info as follows:

Operator.....
Well Name.....
Comp. Date.....Old Total Depth.....

WELL HISTORY

Drilling Method:

- Mud Rotary Air Rotary Cable

3-22-85 3-31-85 3-31-85
Spud Date Date Reached TD Completion Date

4625
Total Depth PBTD

Amount of Surface Pipe Set and Cemented at 347 feet
Multiple Stage Cementing Collar Used? Yes No
If yes, show depth set.....feet
If alternate 2 completion, cement circulated
from.....feet depth to.....w/.....SX cmt

API NO. 15-101-21-150-0000

County Lane

C... S/2 NE... Sec. 5... Twp. 17S Rge. 29 East West

3300 Ft North from Southeast Corner of Section
1320 Ft West from Southeast Corner of Section
(Note: Locate well in section plat below)


Lease Name Buchanan "F" Well # 1

Field Name Wildcat

Producing Formation.....

Elevation: Ground 2816 KB. 2822

Section Plat

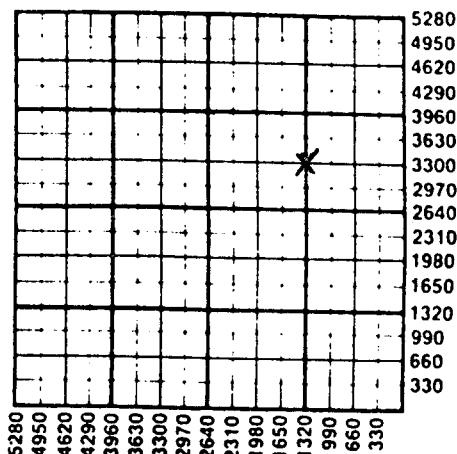

WATER SUPPLY INFORMATION

Disposition of Produced Water: Disposal Repressuring
Docket #

Questions on this portion of the ACO-1 call:

Water Resources Board (913) 296-3717

Source of Water:
Division of Water Resources Permit #.....

Groundwater.....Ft North from Southeast Corner
(Well)Ft West from Southeast Corner of
Sec Twp Rge East West

Surface Water.....Ft North from Southeast Corner
(Stream, pond etc).....Ft West from Southeast Corner
Sec Twp Rge East West

Other (explain).....
(purchased from city, R.W.D. #)


INSTRUCTIONS: This form shall be completed in duplicate and filed with the Kansas Corporation Commission, 200 Colorado Derby Building, Wichita, Kansas 67202, within 90 days after completion or recompletion of any well. Rule 82-3-130 and 82-3-107 apply. Information on side two of this form will be held confidential for a period of 12 months if requested in writing and submitted with the form. See rule 82-3-107 for confidentiality in excess of 12 months. One copy of all wireline logs and drillers time log shall be attached with this form. Submit CP-4 form with all plugged wells. Submit CP-111 form with all temporarily abandoned wells.

All requirements of the statutes, rules and regulations promulgated to regulate the oil and gas industry have been fully complied with and the statements herein are complete and correct to the best of my knowledge.

Signature William R. Horigan
Title Kansas Operations Manager Date 4-2-85

Subscribed and sworn to before me this 2nd day of April 1985

Notary Public Leslie K. Robinson
Date Commission Expires 5-27-85

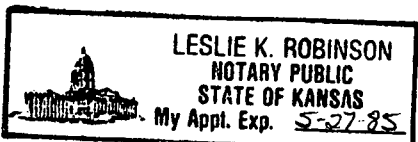

K.C.C. OFFICE USE ONLY
 Letter of Confidentiality Attached
 Wireline Log Received
 Drillers Timelog Received
Distribution
 KCC SWD/Rep NGPA
 KGS Plug Other (Specify)