

This form shall be filed in duplicate with the Kansas Corporation Commission, 200 Colorado Derby Building, Wichita, Kansas 67202, within ten days after the completion of the well, regardless of how the well was completed.

Attach separate letter of request if the information is to be held confidential. If confidential, only file one copy. Information on side one will be of public record and side two will then be held confidential.

Circle one: (Oil) Gas, Dry, SWD, OWWO, Injection. Type and complete ALL sections. Applications must be filed for dual completion, commingling, SWD and injection, T.A.

Attach wireline logs (i.e. electrical log, sonic log, gamma ray neutron log, etc.). KCC # (316) 263-3238. (Rules 82-2-105 & 82-2-125)

OPERATOR Teichgraeber Oil Operations

API NO. 15 169 20,107-0000

ADDRESS Box 471

COUNTY Saline

El Dorado, KS 67042

FIELD HUNTER

**CONTACT PERSON R. K. Teichgraeber

PROD. FORMATION Mississippi

PHONE 316 321 2770

LEASE Peterson

PURCHASER Mobil

WELL NO. 1

ADDRESS Box 900

WELL LOCATION NW NW NW

Dallas, TX 75221

190 Ft. from North Line and

DRILLING FDCO Drilling

370 Ft. from West Line of

CONTRACTOR

ADDRESS Box 645

the SEC. 29 TWP. 16S RGE. 1W


El Dorado, KS 67042

WELL FLAT

PLUGGING

CONTRACTOR

ADDRESS

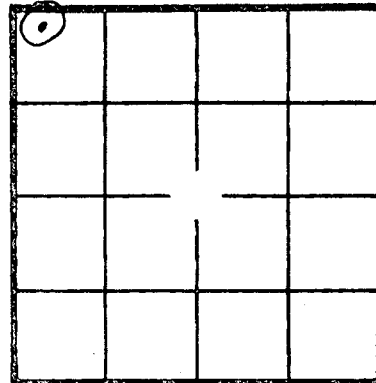

KCC ✓
KGS ✓
(Office Use)

TOTAL DEPTH 2675 PBD 3000

SPUD DATE 03/26/80 DATE COMPLETED 03/31/80

ELEV: GR 1300 DF 1304 KB 1305

DRILLED WITH (CABLE) (ROTARY) (AIR) TOOLS

Amount of surface pipe set and cemented 137 DV Tool Used? [initials]

AFFIDAVIT

STATE OF Kansas, COUNTY OF Butler

SS, I, [initials]
15 1000
01-15-82
CONSERVATION

R. K. Teichgraeber OF LAWFUL AGE, BEING FIRST DULY SWORN UPON HIS OATH,

DEPOSES THAT HE IS the (FOR) (OP)

OPERATOR OF THE Peterson LEASE, AND IS DULY AUTHORIZED TO MAKE

THIS AFFIDAVIT FOR AND ON THE BEHALF OF SAID OPERATOR, THAT WELL NO. 1 ON

SAID LEASE HAS BEEN COMPLETED AS OF THE 31st DAY OF March, 19 80, AND THAT

ALL INFORMATION ENTERED HEREIN WITH RESPECT TO SAID WELL IS TRUE AND CORRECT.

FURTHER AFFIANT SAITH NOT.

SUBSCRIBED AND SWORN BEFORE ME THIS 14 DAY OF Jan, 19 82.

(S) R. K. Teichgraeber

[Signature] HAZEL B. LYNCH
NOTARY PUBLIC STATEWIDE NOTARY

MY COMMISSION EXPIRES: Sept. 16, 1982

BUTLER COUNTY, KANSAS

**The person who can be reached by phone regarding any questions concerning this information. Within 45 days of completion, a witnessed initial test by the Commission is required if the well produces more than 25 BOPD or is located in a Basic Order Pool.