

STATE CORPORATION COMMISSION OF KANSAS
OIL & GAS CONSERVATION DIVISION

WELL COMPLETION OR RECOMPLETION FORM
ACO-1 WELL HISTORY

DESCRIPTION OF WELL AND LEASE

Operator: License # 5151
Name Gear Petroleum Co., Inc.
Address 300 Sutton Place
Wichita, Kansas 67202
City/State/Zip

Purchaser: Inland Crude Purchasing Co.
200 Douglas Bldg. Wichita, KS

Operator Contact Person Jim Thatcher
Phone 316-265-3351

Contractor: License # 5302
Name Red Tiger Drilling Company

Wellsite Geologist Casey Galloway
Phone 316-267-6248

Designate Type of Completion

- New Well Re-Entry Workover
- Oil SWD Temp Abd
- Gas Inj Delayed Comp.
- Dry Other (Core, Water Supply etc)

If OWWO: old well info as follows:

Operator
Well Name
Comp. Date Old Total Depth

WELL HISTORY

Drilling Method:
 Mud Rotary Air Rotary Cable
10/9/84 10/22/84 1/3/85
Spud Date Date Reached TD Completion Date
4650 4582
Total Depth PBDT

Amount of Surface Pipe Set and Cemented at 338 feet
Multiple Stage Cementing Collar Used? Yes No
If yes, show depth set 1119 feet
If alternate 2 completion, cement circulated from 1119 feet depth to Surface/260 SX cmt

API NO. 15-101-21057-0000

County Lane

SE NE NW Sec. 15 Twp. 17 Rge. 29 East West

4290 Ft North from Southeast Corner of Section
2970 Ft West from Southeast Corner of Section
(Note: Locate well in section plat below)


Lease Name Snider Well # 2-15

Field Name North Trail

Producing Formation LKC

Elevation: Ground 2799 KB 2804

Section Plat

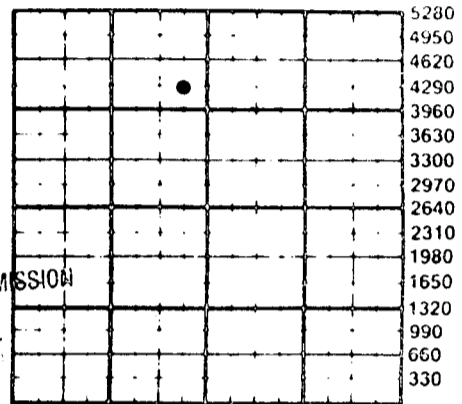

RECEIVED
01-10-1985
STATE CORPORATION COMMISSION
Wichita, Kansas

WATER SUPPLY INFORMATION

Disposition of Produced Water: Disposal Repressuring
Docket #

Questions on this portion of the ACO-1 call:

Water Resources Board (913) 296-3717
Source of Water:
Division of Water Resources Permit # 4298

Groundwater 4290 Ft North from Southeast Corner
3045 Ft West from Southeast Corner of
Sec 15 Twp 17 Rge 29 East West
 Surface Water Ft North from Southeast Corner
(Stream, pond etc) Ft West from Southeast Corner
Sec Twp Rge East West
 Other (explain) (purchased from city, R.W.D. #)

INSTRUCTIONS: This form shall be completed in duplicate and filed with the Kansas Corporation Commission, 200 Colorado Derby Building, Wichita, Kansas 67202, within 90 days after completion or recompletion of any well. Rule 82-3-130 and 82-3-107 apply. Information on side two of this form will be held confidential for a period of 12 months if requested in writing and submitted with the form. See rule 82-3-107 for confidentiality in excess of 12 months. One copy of all wireline logs and drillers time log shall be attached with this form. Submit CP-4 form with all plugged wells. Submit CP-111 form with all temporarily abandoned wells.

All requirements of the statutes, rules and regulations promulgated to regulate the oil and gas industry have been fully complied with and the statements herein are complete and correct to the best of my knowledge.

Signature

Title Drilling & Production Manager Date 1/9/85

Subscribed and sworn to before me this 9th day of January 1985

Notary Public Helen L. Coyer

Date Commission Expires April 1, 1986



K.C.C. OFFICE USE ONLY

- Letter of Confidentiality Attached
- Wireline Log Received
- Drillers Time Log Received
- KCC
- KGS
- SWD/Rep
- Plug
- NGPA
- Other (Specify)

