


STATE OF KANSAS
STATE CORPORATION COMMISSION

WELL PLUGGING RECORD

Give All Information Completely
Make Required Affidavit
Mail or Deliver Report to:
Conservation Division
State Corporation Commission
800 Bittling Building
Wichita, Kansas

Scott County, Sec. 20 Twp. 18S Rge. 31 (E) (W)
SW SW SW

Location as "NE/CNW/4SW 1/4" or footage from lines
Lease Owner **Peel-Hardman**
Lease Name **Taylor** Well No. **1**
Office Address **Box 359 Hoisington, Kansas**
Character of Well (completed as Oil, Gas or Dry Hole) **Dry Hole**
Date well completed **March 19 19 51**
Application for plugging filed **March 19 19 51**
Application for plugging approved **March 19 19 51**
Plugging commenced **March 19 19 51**
Plugging completed **March 19 19 51**
Reason for abandonment of well or producing formation **Dry Hole**

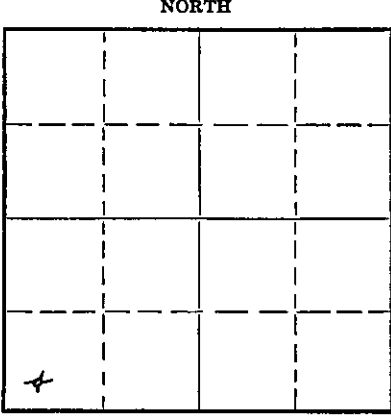

Locate well correctly on above Section Plat

If a producing well is abandoned, date of last production _____ 19____
Was permission obtained from the Conservation Division or its agents before plugging was commenced? **Yes**


Name of Conservation Agent who supervised plugging of this well **C. D. Stough**
Producing formation _____ Depth to top _____ Bottom _____ Total Depth of Well **4580'** Feet
Show depth and thickness of all water, oil and gas formations.

OIL, GAS OR WATER RECORDS CASING RECORD

Formation	Content	From	To	Size	Put In	Pulled Out
		0	250'	8 5/8"	250'	None

Describe in detail the manner in which the well was plugged, indicating where the mud fluid was placed and the method or methods used in introducing it into the hole. If cement or other plugs were used, state the character of same and depth placed, from _____ feet to _____ feet for each plug set.

4580' to 251 1/2' - Heavy Rotary Mud
251 1/2' to 250' - Wooden Plug
250' to 204' - 15 sacks of cement
204' to 31 1/2' - Heavy Rotary Mud
31 1/2' to 30' - Wooden Plug
30' to 6' - 10 sacks of cement
6' to Surface - Cellar

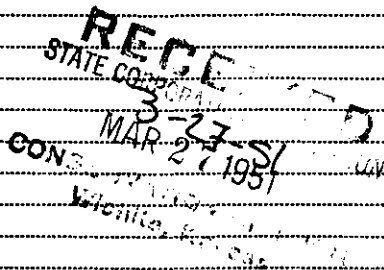

(If additional description is necessary, use BACK of this sheet)

Correspondence regarding this well should be addressed to **Peel-Hardman**
Address **Box 359 Hoisington, Kansas**

STATE OF **Kansas**, COUNTY OF **Barton**, ss.

Glenn W. Peel (owner or operator) of the above-described well,
being first duly sworn on oath, says: That I have knowledge of the facts, statements, and matters herein contained and the log of the above-described well as filed and that the same are true and correct. So help me God. **GLENN W. PEEL**

(Signature) BY: *Glenn W. Peel*
P. O. BOX 359 HOISINGTON, KANSAS
(Address)

SUBSCRIBED AND SWORN to before me this **26th** day of **March**, 19**51**

My commission expires June 4, 1951

PLUGGING
FILE SEC 20 T 18 R 31W
BOOK PAGE 68 LINE 16

Manan M. Herfel
Notary Public.

DRILLER'S LOG

Company: Peel-Hardman SW SW SW
 Farm: Taylor Well No. 1 Sec. 20, Twp. 18S, Rge. 31W,
 Total Depth: 4580' County: Scott,
 Kansas
 Comm: 2-21-51 Comp: 3-19-51 Elevation:
 Contractor: Glenn W. Peel Production: Dry
 Casing: 8 5/8" 250' cem.

Figures below indicate bottom of formations

Surface Soil	0 -	65
Sand		105
Sand & Shale		230
Shale & Shells		250
Shale		800
Shells & Shale		1415
Shale		1745
Anhydrite		1785
Shale		2235
Shale & Shells		2465
Shale		2655
Shale & Shells		2790
Shale		2885
Lime & Shale		3020
Lime		3185
Lime & Shale		3265
Lime		3490
Shale & Lime		3810
Lime		4580
Total Depth		4580

This is to certify that the above information is, to the best of our knowledge true and correct.

GLENN W. PEEL

BY: Wm Herbert

SUBSCRIBED AND SWORN to before me this 26th day of March, 1951.

My commission expires June 4, 1951 Marion M. Herbert
Notary Public

3-27-51
RECEIVED
MARCH 27 1951

PLUGGING
FILE SEC 20 T 18 R 31W
BOOK PAGE 48 LINE 16