

15101-00022-0800

WELL PLUGGING RECORD

Give All Information Completely
Make Required Affidavit
Mail or Deliver Report to:
Conservation Division
State Corporation Commission
211 No. Broadway
Wichita, Kansas

Lane _____ County. Sec. 33 Twp. 19S Rge. 27(W)

Location as "NE/CNW/SW" or footage from lines 150' N of Center SE SW*

Lease Owner Gulf Oil Corporation

Lease Name W. J. Lewis Well No. 1

Office Address Box 661, Tulsa, Oklahoma

Character of Well (completed as Oil, Gas or Dry Hole) Dry hole

Date well completed 12-21 1957

Application for plugging filed 12-20 1957

Application for plugging approved Verbally 12-20-57, Letter 12-23 1957


Plugging commenced 12-20 1957

Plugging completed 12-21 1957

Reason for abandonment of well or producing formation Dry hole

If a producing well is abandoned, date of last production - - - 19 -

Was permission obtained from the Conservation Division or its agents before plugging was commenced? Yes

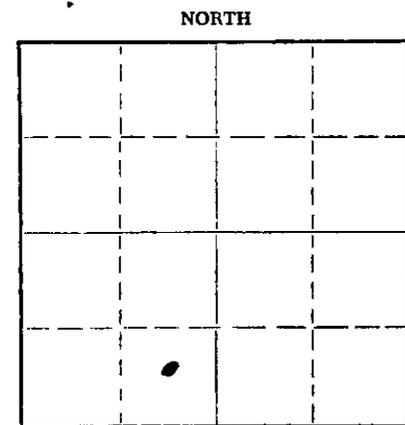

Locate well correctly on above Section Plat

Name of Conservation Agent who supervised plugging of this well Don Peterson

Producing formation _____ Depth to top _____ Bottom _____ Total Depth of Well 4671* Feet

Show depth and thickness of all water, oil and gas formations.

OIL, GAS OR WATER RECORDS

CASING RECORD

FORMATION	CONTENT	FROM	TO	SIZE	PUT IN	PULLED OUT
				8-5/8"	1232'	-0-

Describe in detail the manner in which the well was plugged, indicating where the mud fluid was placed and the method or methods used in introducing it into the hole. If cement or other plugs were used, state the character of same and depth placed, from _____ feet to _____ feet for each plug set.

Filled hole with mud to 1200'. Set HOWCO plug, $\frac{1}{2}$ sack hulls, and 20 sx. cement from 1200-1140'. Filled with mud to 300'. Set HOWCO plug, $\frac{1}{2}$ sack hulls, and 20 sx. cement from 300-240'. Filled with mud to 30'. Set HOWCO plug, $\frac{1}{2}$ sack hulls, and capped with 10 sx. cement, filling hole into cellar.

* Location as shown on Intention to Drill and Well Plugging Application was in error. Above is correct well location. Also, application showed TD as 4761'. This should have been 4671', as shown.

Attached is Drillers Formation Record, which was not available at time application was filed.

NOTE: W. C. Bunch - Special Petty Cash, Check No. 1983, dated 12-31-57, in the amount of \$46.71, is attached as payment of plugging assessment.

RECEIVED
STATE CORPORATION COMMISSION

JAN 1 1958
1-4-58

Name of Plugging Contractor Gabbert-Jones Drilling Company
Address Wichita, Kansas

STATE OF Kansas, COUNTY OF Sedgwick, ss.
Thomas A. Trax (employee of owner) of the above-described

well, being first duly sworn on oath, says: That I have knowledge of the facts, statements, and matters herein contained and the log of the above-described well as filed and that the same are true and correct. So help me God.

(Signature) [Signature]

Box 2233, Wichita, Kansas
(Address)

SUBSCRIBED AND SWORN TO before me this 23rd day of December, 1957

My commission expires 6-3-61 C. C. LEWIS, NOTARY PUBLIC

JRM:PF

PLUGGING
FILE NO 33 19 R 270
BOOK PAGE 71 LI E 12

JAN 4 1958
CONSERVATION DIVISION
Wichita, Kansas

CANNETT-LEWIS DRILLING CO., INC.

WICHITA, KANSAS

DRILLER'S WELL LOG

WESLEY J. LEWIS #1
 S 35 SW SECTION 33-19-27
 LEWIS COUNTY, KANSAS
 COMMENCED 11-30-57
 COMPLETED 12-30-57

15-101-00022-0000

DEPTH		FORMATION	REMARKS
FROM	TO		
0	65	SURFACE CLAY	
65	75	SAND	
75	719	SHALE & SHELLS	
719	762	SAND	
762	825	SAND & SHALE	
825	1130	SHALE & SHELLS	
1130	1210	SHALE, SHELLS & RED BED	
1210	1233	RED BED	
1233	1900	SHALE, RED BED & SAND	
1900	2010	RED BED & SHALE	
2010	2295	SHALE & SHELLS	
2295	2460	SHALE, SHELLS & RED BED	
2460	2735	LIME & SHALE	
2735	2775	LIME, SHALE & CHALK	
2775	2960	LIME & SHALE	
2960	4551	LIME	
4551	4600	LIME & CHERT	
4600	4875	LIME	
4875		TO	

RAN 30 JOINTS 8-5/8" CASING,
 CEMENTED @ 1233' WITH 900 BAGS
 CEMENT.

DRY & ABANDONED

I, E. E. Hall, CERTIFY THIS TO BE A TRUE AND CORRECT COPY OF THE DRILLER'S WELL LOG FOR THE WESLEY J. LEWIS #1.

E. E. Hall
 E. E. HALL

STATE OF KANSAS }
 COUNTY OF SEDGWICK } SS:

BEFORE ME, THE UNDERSIGNED, A NOTARY PUBLIC, WITHIN AND FOR SAID COUNTY AND STATE, ON THIS 21st DAY OF DECEMBER, 1957 PERSONALLY APPEARED E. E. Hall TO ME PERSONALLY KNOWN TO BE THE IDENTICAL PERSON WHO EXECUTED THE WITHIN AND FOREGOING INSTRUMENT AND ACKNOWLEDGED TO ME THAT HE EXECUTED THE SAME AS HIS FREE AND VOLUNTARY ACT AND DEED FOR THE USES AND PURPOSES THEREIN SET FORTH.

IN WITNESS WHEREOF, I HAVE HEREUNTO SET MY NAME AND OFFICIAL SEAL THE DAY AND YEAR LAST ABOVE WRITTEN.

[Signature]
 NOTARY PUBLIC

MY COMMISSION EXPIRES NOVEMBER 9, 1959.

PLUGGING
 FILE SEC 33T 19R 274
 BOOK PAGE 41 LINE 10

RECEIVED
 STATE CORPORATION COMMISSION
 JAN 4 1958
 1-4-58
 CONSERVATION DIVISION
 Wichita, Kansas

