

STATE OF KANSAS
STATE CORPORATION COMMISSION

Form CP-4

Give All Information Completely
Make Required Affidavit
Mail or Deliver Report to:
Conservation Division
State Corporation Commission
212 No. Market
Wichita, Kansas

WELL PLUGGING RECORD

Scott County, Sec. 30 Twp. 18S Rge. - (E) 31 (W)

Location as "NE/CNW&SW&" or footage from lines SW¹/₄ NW¹/₄ NW¹/₄

Lease Owner Amerada Petroleum Corporation

Lease Name L. T. Chance Well No. 1

Office Address Box 369, Woodward, Oklahoma - 73801

Character of Well (completed as Oil, Gas or Dry Hole) Gas Well

Date well completed 1/24/ 19 51

Application for plugging filed 7/13/ 19 66

Application for plugging approved 7/14/ 19 66


Plugging commenced 7/26/ 19 66

Plugging completed 7/28/ 19 66

Reason for abandonment of well or producing formation Watered out-unable to produce.

If a producing well is abandoned, date of last production April 11 19 66

Was permission obtained from the Conservation Division or its agents before plugging was commenced? Yes

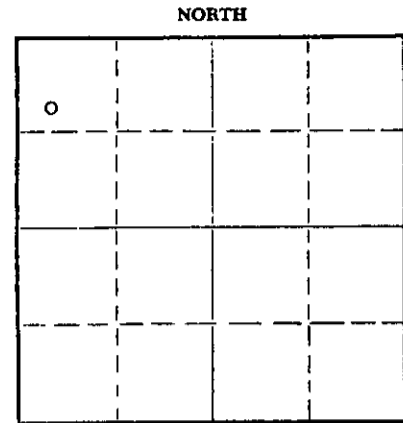

Locate well correctly on above Section Plat

Name of Conservation Agent who supervised plugging of this well Leo Massey, Hays, Kansas

Producing formation Herrington Depth to top 2743' Bottom 2898' Total Depth of Well 4152' Feet

Show depth and thickness of all water, oil and gas formations.

OIL, GAS OR WATER RECORDS

CASING RECORD

FORMATION	CONTENT	FROM	TO	SIZE	PUT IN	PULLED OUT
				8-5/8	281'	None
				5-1/2	3037'	1732'

Describe in detail the manner in which the well was plugged, indicating where the mud fluid was placed and the method or methods used in introducing it into the hole. If cement or other plugs were used, state the character of same and depth placed, from _____ feet to _____ feet for each plug set.

- Filled hole with heavy mud from 2740' to 300'
- Spotted rock bridge from 300' to 290'
- Spotted cement plug from 290' to 200' w/30 sax cement
- Filled hole with heavy mud from 200' to 40' w/30 sax cement
- Spotted cement plug from 40' to bottom of cellar w/15 sax cement

RECEIVED
STATE CORPORATION COMMISSION
AUG 2 1966
8-2-66
CONSERVATION DIVISION
WICHITA, KANSAS

(If additional description is necessary, use BACK of this sheet)

Name of Plugging Contractor Glenn and Smith, Casing Pulling Co.

Address Ellinwood, Kansas.

STATE OF Oklahoma, COUNTY OF Ellis, ss.
D. E. Holbrook (employee of owner) or (owner or operator) of the above-described well, being first duly sworn on oath, says: That I have knowledge of the facts, statements, and matters herein contained and the log of the above-described well as filed and that the same are true and correct. So help me God.

(Signature) *D. E. Holbrook*

Box 369, Woodward, Oklahoma. 73801 (Address)

SUBSCRIBED AND SWORN TO before me this 29th day of July, 19 66

Notary Public

My commission expires 9/6/68


Notary Public.


45-74860-33-2200

State of _____
 County of _____
 I, _____
 do hereby certify that _____
 is the true and correct _____
 of _____

RECEIVED
 STATE CORPORATION COMMISSION
 JUL 15 1966

Subscribed and sworn to before me on this _____ day of _____ 19____

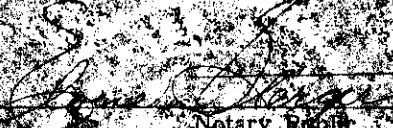
 Notary Public
 My commission expires _____


 By _____
 Title _____