


Give All Information Completely  
Make Required Affidavit  
Mail or Deliver Report to:  
Conservation Division  
State Corporation Commission  
211 No. Broadway  
Wichita, Kansas

WELL PLUGGING RECORD

NORTH

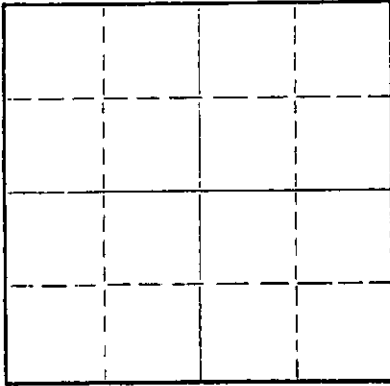

Locate well correctly on above  
Section Plat

Scott County. Sec. 30 Twp. 18 Rge. 31 (E) (W) X  
Location as "NE/CNW&SW" or footage from lines NE NW NW  
Lease Owner Underwriters' Oil Corporation  
Lease Name Chance Well No. 1  
Office Address 300 Weber Bldg., Lake Charles, Louisiana  
Character of Well (completed as Oil, Gas or Dry Hole) D & A  
Date well completed June 24, 1963 19  
Application for plugging filed June 26, 1963 19  
Application for plugging approved 19  
Plugging commenced June 24, 1963 19  
Plugging completed " " 19  
Reason for abandonment of well or producing formation D & A

If a producing well is abandoned, date of last production 19  
Was permission obtained from the Conservation Division or its agents before plugging was commenced? XX Yes

Name of Conservation Agent who supervised plugging of this well Bill Nichols  
Producing formation \_\_\_\_\_ Depth to top \_\_\_\_\_ Bottom \_\_\_\_\_ Total Depth of Well 4015 Feet  
Show depth and thickness of all water, oil and gas formations.

OIL, GAS OR WATER RECORDS

CASING RECORD

FORMATION	CONTENT	FROM	TO	SIZE	PUT IN	PULLED OUT

Describe in detail the manner in which the well was plugged, indicating where the mud fluid was placed and the method or methods used in introducing it into the hole. If cement or other plugs were used, state the character of same and depth placed, from \_\_\_\_\_ feet to \_\_\_\_\_ feet for each plug set.

1st @ 540 w/20 sx.  
2nd @ 250 w/20 wx.  
3rd @ 40 w/10 sx.

RECEIVED  
STATE CORPORATION COMMISSION

JUN 27 1963  
6-27-63

CONSERVATION DIVISION  
Wichita, Kansas

(If additional description is necessary, use BACK of this sheet)  
Name of Plugging Contractor National Drilling Co., Inc.  
Address 531 Petroleum Bldg., Wichita 2, Kansas

STATE OF Kansas COUNTY OF Sedgwick, ss.  
Howard A. Stoskopf (employee of owner) or (owner or operator) of the above-described

well, being first duly sworn on oath, says: That I have knowledge of the facts, statements, and matters herein contained and the log of the above-described well as filed and that the same are true and correct. So help me God.

(Signature)

Nat'l. Drlg. Co., Inc., 531 Petroleum Bldg.  
(Address) Wichita, Kansas

SUBSCRIBED AND SWORN TO before me this 26th day of June 1963

My commission expires July 5, 1966

INVOICED

DATE 6/27/63

INV. NO. 7327-W

Marilyn F. Grove  
Notary Public.

**KANSAS GEOLOGICAL SOCIETY**  
**KANSAS WELL LOG BUREAU - KANSAS WELL SAMPLE BUREAU**  
 KANSAS GEOLOGICAL SOCIETY BUILDING  
 508 EAST MURDOCK - WICHITA, KANSAS

15-171-19011-0000

COMPANY *Underwriters Oil Corporation*


SEC. 30 T. 18 R. 31W  
 LOC. NE NW NW

FARM *Chance*

NO. 1

TOTAL DEPTH *4015*  
 COMM. *6/13/63* COMP. *6/24/63*  
 SHOT OR TREATED  
 CONTRACTOR *National Drilling Co., Inc.*  
 ISSUED

COUNTY *Scott*

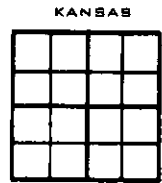

CASING

20	10
15	8 5/8
12	6
13	5

ELEVATION *KB 2970*

PRODUCTION *D & A*

FIGURES INDICATE BOTTOM OF FORMATIONS

<i>Clay</i>	<i>35</i>
<i>Sand</i>	<i>98</i>
<i>Sand</i>	<i>275</i>
<i>Shale 1110</i>	<i>1110</i>
<i>Sahle &amp; Red Bed</i>	<i>1450</i>
<i>Shale and Lime Shells</i>	<i>1583</i>
<i>Shale &amp; Lime</i>	<i>1721</i>
<i>Shale</i>	<i>2215</i>
<i>Shale</i>	<i>2340</i>
<i>Sahle &amp; Lime</i>	<i>3286</i>
<i>Lime &amp; Shale</i>	<i>3893</i>
<i>Lime, Shale &amp; Chalk</i>	<i>3946</i>
<i>Lime</i>	<i>4015</i>

*I hereby certify that this a true and correct log of the above described well as shown by the drilling reports.*

*Howard A. Stoskopf*  
 \_\_\_\_\_  
 Howard A. Stoskopf

*State of Kansas*  
*County of Sedgwick*

*Subscribed and sworn to before me in and for said county and state this 26th day of June, 1963.*

*Marilyn F. Grove*  
 \_\_\_\_\_  
 Marilyn F. Grove, Notary  
 Public

*My commission expires:*

*July 5, 1966*

**RECEIVED**  
 STATE CORPORATION COMMISSION

JUN 27 1963  
 6-27-63  
 CONSERVATION DEPARTMENT  
 Wichita, Kansas