

STATE OF KANSAS  
STATE CORPORATION COMMISSION

CORRECTED COPY

Form CP-4


WELL PLUGGING RECORD

Give All Information Completely  
Make Required Affidavit  
Mail or Deliver Report to:  
Conservation Division  
State Corporation Commission  
212 No. Market  
Wichita, Kansas

Scott County, Sec. 33 Twp. 18 Rge. 31W (E) (W)

Location as "NE/CNW/SE" or footage from lines. C SE SE  
Lease Owner Yucca Petroleum Company  
Lease Name Blume #1 Well No.  
Office Address Box 2585, Amarillo, Texas 79105  
Character of Well (completed as Oil, Gas or Dry Hole) dry hole  
Date well completed 8-5 19 68  
Application for plugging filed 8-5 19 68  
Application for plugging approved 8-5 19 68  
Plugging commenced 8-5 19 68  
Plugging completed 8-5 19 68  
Reason for abandonment of well or producing formation dry hole

NORTH

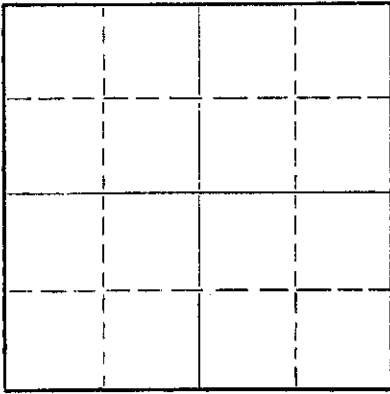

Locate well correctly on above  
Section Plat

If a producing well is abandoned, date of last production 19  
Was permission obtained from the Conservation Division or its agents before plugging was commenced? yes

Name of Conservation Agent who supervised plugging of this well W. L. Nichols  
Producing formation Depth to top Bottom Total Depth of Well 2857 Feet  
Show depth and thickness of all water, oil and gas formations.

OIL, GAS OR WATER RECORDS

CASING RECORD

FORMATION	CONTENT	FROM	TO	SIZE	PUT IN	PULLED OUT
				8 5/8"	288.74	none

Describe in detail the manner in which the well was plugged, indicating where the mud fluid was placed and the method or methods used in introducing it into the hole. If cement or other plugs were used, state the character of same and depth placed, from feet to feet for each plug set.

100 sacks at 1100', 30 sacks at 300', and 10 sacks in top of 8-5/8" to a depth of 40'

RECEIVED  
STATE CORPORATION COMMISSION  
SEP 5 - 1968  
CONSERVATION DIVISION  
Wichita, Kansas

(If additional description is necessary, use BACK of this sheet)

Name of Plugging Contractor Leben Drilling, Inc.  
Address Box 486, Great Bend, Kansas 67530

STATE OF Kansas, COUNTY OF Barton, ss.

(employee of owner) or (owner or operator) of the above-described well, being first duly sworn on oath, says: That I have knowledge of the facts, statements, and matters herein contained and the log of the above-described well as filed and that the same are true and correct. So help me God.

(Signature) Lealie Kite

(Address)

SUBSCRIBED AND SWORN TO before me this 9th day of August, 1968

Ulanda Nichols  
Notary Public.

My commission expires April 1, 1971

