

15-171-20/31-0000

STATE OF KANSAS  
STATE CORPORATION COMMISSION

WELL PLUGGING RECORD

Give All Information Completely  
Make Required Affidavit  
Mail or Deliver Report to  
Conservation Division  
State Corporation Comm.  
245 North Water  
Wichita, KS 67202

Scott County. Sec. 35 Twp. 18S Rge. 31W E/W  
Location as "NE/CNW $\frac{1}{2}$ SW $\frac{1}{2}$ " or footage from lines  
Car-Ren, Inc.


Lease Owner \_\_\_\_\_  
Lease Name Kohrs #1-35 Well No. \_\_\_\_\_  
Office Address Suite 645 300 W. Douglas Wichita, Ks. 67202  
Character of Well (Completed as Oil, Gas or Dry Hole) \_\_\_\_\_  
Dry Hole

Date Well completed 1-21-77 19  
Application for plugging filed 1-21-77 19  
Application for plugging approved 1-21-77 19  
Plugging commenced 1-21-77 19  
Plugging completed 1-21-77 19  
Reason for abandonment of well or producing formation \_\_\_\_\_

Dry Hole  
If a producing well is abandoned, date of last production 19

Was permission obtained from the Conservation Division or its agents before plugging was commenced? Yes

Name of Conservation Agent who supervised plugging of this well S. P. Baltazor  
Producing formation \_\_\_\_\_ Depth to top \_\_\_\_\_ Bottom \_\_\_\_\_ Total Depth of Well \_\_\_\_\_  
Show depth and thickness of all water, oil and gas formations.

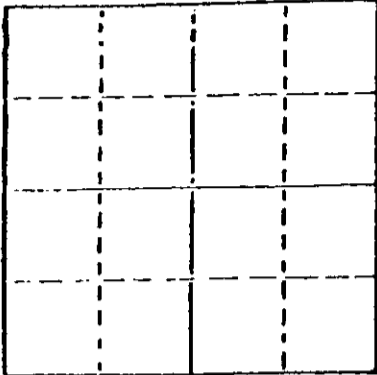

Locate well correctly on above Section Plot

OIL, GAS OR WATER RECORDS

CASING RECORD

FORMATION	CONTENT	FROM	TO	SIZE	PUT IN	PULLED OUT

Describe in detail the manner in which the well was plugged, indicating where the mud fluid was placed and the method or methods used in introducing it into the hold. If cement or other plugs were used, state the character of same and depth placed, from \_\_\_\_\_ feet to \_\_\_\_\_ feet for each plug set.

1st @ 1000 w/70 sax 50-50 of Gel  
2nd @ 300 w/20 sax  
3rd @ 40 w/10 sas  
5 sax inut Hole  
Complete @ 10:45 a.m. 1-21-77  
By Howar  
S. P. Baltazor

RECEIVED  
STATE CORPORATION COMMISSION  
MAR 02 1977  
3-2-77  
CONSERVATION DIVISION  
Wichita, Kansas

(If additional description is necessary, use BACK of this sheet)

Name of Plugging Contractor Gabbert-Jones, Inc.


STATE OF Kansas COUNTY OF Sedgwick, ss.  
(employee of owner) or (owner or operator)  
of the above-described well, being first duly sworn on oath, says: That I have knowledge of the facts, statements, and matters herein contained and the log of the above-described well as filed and that the same are true and correct. So help me God.

(Signature) James S. Sutton II

(Address) 830 Sutton Place

SUBSCRIBED AND SWORN TO before me this 1 day of March, 19 77

Elizabeth J. Edwards  
Elizabeth J. Edwards Notary Public.

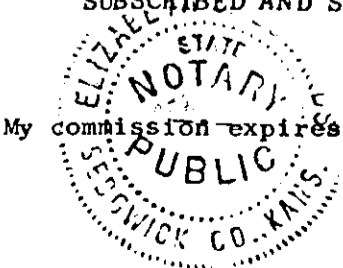

2-6-79

15-171-20131-0000

GABBERT-JONES, INC.  
WICHITA, KANSAS  
DRILLERS' WELL LOG

RECEIVED  
CORPORATION DIVISION  
WICHITA, KANSAS

JAN 31 1977  
1-31-77  
CORPORATION DIVISION  
Wichita, Kansas

Kohrs #1-35  
C-NW-NW Sec 35-18S-31W  
Scott County, Kansas

Commenced: 1-17-77

Completed: 1-21-77

OPERATOR: CAR-REN, INC.

Depth		Formation	Remarks
From	to		
0	40	Surface Sand	Ran 9 jts of 8 5/8" csg set @
40	380	Sand-Clay	380' cement w/265 Common
380	2329	Shale	3% CC - 1/4" Floseal
2329	2657	Shale-Lime	PD @ 9:00 p.m. 1-17-77
2657	2835	Lime-Shale	
	2835 TD		

STATE OF KANSAS )  
                          ) SS  
COUNTY OF SEDGWICK)

I, the undersigned, being duly sworn on oath, state that the above Drillers' Well Log is true and correct to the best of my knowledge and belief and according to the records of this office.

GABBERT-JONES, INC.

*James S. Sutton II*  
JAMES S. SUTTON II

Subscribed and sworn to before me this 27th day of January, 1977.

*Elizabeth J. Edwards*  
ELIZABETH J. EDWARDS-NOTARY PUBLIC

My Commission expires February 6, 1979.

