

CARD MUST BE TYPED

State of Kansas

CARD MUST BE SIGNED ✓

NOTICE OF INTENTION TO DRILL

(see rules on reverse side)

Expected Spud Date..... 8 3 87
 month day year

API Number 15— 101-21,405-00-00
100' N of
S/2 S/2 SE Sec. 11 Twp. 17. S, Rg. 29 X West
 430 Ft. from South Line of Section
 1320 Ft. from East Line of Section

OPERATOR: License # 5123
Name Pickrell Drilling Company, Inc.
Address 110 N. Market, Suite 205
City/State/Zip Wichita, Kansas 67202
Contact Person Jay McNeil
Phone 262-8427

(Note: Locate well on Section Plat on reverse side)
Nearest lease or unit boundary line .. 430 feet
County..... Lane

CONTRACTOR: License # 5123
Name Pickrell Drilling Company, Inc.
City/State Wichita, Kansas

Lease Name..... James Well # ... 1-'E' ...
Ground surface elevation ... 2791 feet MSL
Domestic well within 330 feet: ___yes Xno
Municipal well within one mile: ___yes Xno

Well Drilled For: Well Class: Type Equipment:
X Oil ___ Storage ___ Infield X Mud Rotary
___ Gas ___ Inj X Pool Ext. ___ Air Rotary
___ OWWO ___ Expl ___ Wildcat ___ Cable

Depth to bottom of fresh water..... 180
Depth to bottom of usable water 1100
Surface pipe by Alternate: 1 ___ 2 X

If OWWO: old well info as follows:

Surface pipe planned to be set ... 350+ feet
Conductor pipe required
Projected Total Depth 4650 feet
Formation..... Mississippi

Operator
Well Name
Comp Date Old Total Depth.....

I certify that well will comply with K.S.A. 55-101, et seq., plus eventually plugging hole to KCC specifications.

Date 7-30-87 Signature of Operator or Agent Jay McNeil Title..... Chief Geologist

For KCC Use:


Conductor Pipe Required feet; Minimum Surface Pipe Required 200 feet per Alt. X
This Authorization Expires 1-30-88 Approved By JM 7-30-87

Must be filed with the K.C.C. five (5) days prior to commencing well
This card void if drilling not started within six (6) months of date received by K.C.C.

Important procedures to follow:

1. Notify District office before setting surface casing.
2. Set surface casing by circulating cement to the top.
3. File completion forms ACO-1 with K.C.C. within 120 days of well spud date, following instructions on ACO-1, side 1, and including copies of wireline logs.
4. Notify District office 48 hours prior to old well workover or re-entry.
5. Prior to filing Intent, prepare a proposed plugging plan in case well is D & A, then obtain approval of plan when calling district office prior to setting surface pipe.
6. Submit plugging report (CP-4) to K.C.C. after plugging is completed.
7. Obtain an approved injection docket number before disposing of salt water.
8. Notify K.C.C. within 10 days when injection commences or terminates.
9. If an alternate 2 completion, cement in the production pipe from below any usable water to surface within 120 days of spud date.

**A Regular Section of Land
1 Mile = 5,280 Ft.**

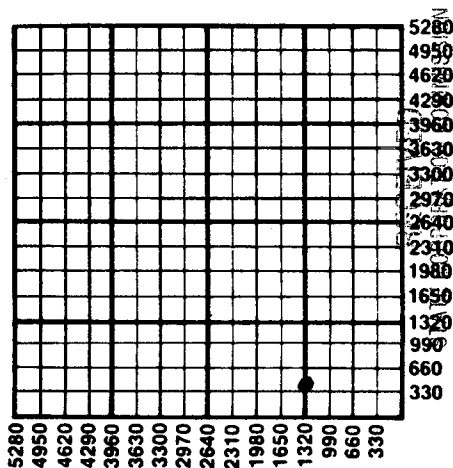

JUL 30 1987

CONSERVATION DIVISION
Wichita, Kansas

07-30-1987

State Corporation Commission of Kansas
Conservation Division
200 Colorado Derby Building
Wichita, Kansas 67202-1212
(316) 263-3238