

CARD MUST BE TYPED

CORRECTED LOCATION
State of Kansas
NOTICE OF INTENTION TO DRILL

CARD MUST BE SIGNED
COLLECTOR
2-1986

Starting Date February 24 1986
month day year

API Number 15- 101-21,291 0000

OPERATOR: License # 9427
Name Sharp Engineering
Address 708 One Main Place
City/State/Zip Wichita, Kansas 67202
Contact Person Mari Rech
Phone 316-265-9825

* N/2 SE. NE. Sec. 15. Twp. 17. S. Rg. 29. East
* 3630. Ft. from South Line of Section
660 Ft. from East Line of Section

(Note: Locate well on Section Plat on reverse side)

CONTRACTOR: License # 5302
Name Red Tiger Drilling
City/State Wichita, Kansas 67202

Nearest lease or unit boundary line 330 feet
County Lane

Lease Name F. Eaton Well # 1

Ground surface elevation _____ feet MSL

Domestic well within 330 feet: _____yes no

Municipal well within one mile: _____yes no

Depth to bottom of fresh water 150

Depth to bottom of usable water 1100

Surface pipe by Alternate: 1 2

Surface pipe planned to be set 325

Conductor pipe required _____

Projected Total Depth 4650 feet

Formation Mississippi

Well Drilled For: Well Class: Type Equipment:
 Oil SWD Infield Mud Rotary
 Gas Inj Pool Ext. Air Rotary
 OWWO Expl Wildcat Cable

If OWWO: old well info as follows:

Operator _____

Well Name _____

Comp Date _____ Old Total Depth _____

I certify that well will comply with K.S.A. 55-101, et seq., plus eventually plugging hole to KCC specifications.

Date 2/17/86 Signature of Operator or Agent Gary Sharp Title Agent

For KCC Use:

Conductor Pipe Required _____ feet; Minimum Surface Pipe Required 200 feet per Alt. ②

This Authorization Expires 8-12-86 Approved By [Signature] 2-12-86


was E/2 NE 3960 FSL

Must be filed with the K.C.C. five (5) days prior to commencing well
This card void if drilling not started within six (6) months of date received by K.C.C.

Important procedures to follow:

1. Notify District office before setting surface casing.
2. Set surface casing by circulating cement to the top.
3. File completion forms ACO-1 with K.C.C. within 90 days of well completion, following instructions on ACO-1, side 1, and including copies of wireline logs.
4. Notify District office 48 hours prior to old well workover or re-entry.
5. Prior to filing Intent, prepare a proposed plugging plan in case well is D & A, then obtain approval of plan when calling district office prior to setting surface pipe.
6. Submit plugging report (CP-4) to K.C.C. after plugging is completed.
7. Obtain an approved injection docket number before disposing of salt water.
8. Notify K.C.C. within 10 days when injection commences or terminates.
9. If an alternate 2 completion, cement in the production pipe from below any usable water to surface within 120 days of spud date.

A Regular Section of Land 1 Mile = 5,280 Ft.

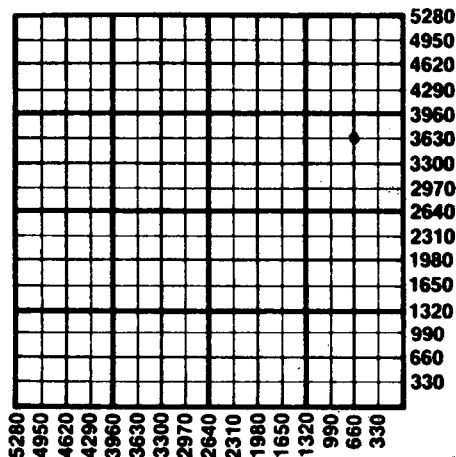

RECEIVED
STATE CORPORATION COMMISSION
02-20-1986
FEB 20 1986
CONSERVATION DIVISION
Wichita, Kansas

State Corporation Commission of Kansas
Conservation Division
200 Colorado Derby Building
Wichita, Kansas 67202
(316) 263-3238