

CARD MUST BE TYPED

State of Kansas
NOTICE OF INTENTION TO DRILL

CARD MUST BE SIGNED

(see rules on reverse side)

Starting Date: Nov. 15 1984
month day year

API Number 15- 101-21,084-00-00

OPERATOR: License # 5254

NE SW SW Sec 23 Twp 17 S, Rge 29 East
(location) West

Name Midco Exploration, Inc.

Address 200 E. First St. - Suite 411

City/State/Zip Wichita, Ks. 67202

Contact Person Harvey Gough

Phone 316-267-3613

990 Ft North from Southeast Corner of Section

4290 Ft West from Southeast Corner of Section

(Note: Locate well on Section Plat on reverse side)

CONTRACTOR: License # 5104

Nearest lease or unit boundary line 990 feet.

County Lane

Name Blue Goose Drilling, Inc.

Lease Name Borell 'A' Well# 1

City/State Great Bend, Ks. 67530

Well Drilled For: Well Class: Type Equipment:

- Oil Swd Infield Mud Rotary
- Gas Inj Pool Ext. Air Rotary
- OWWO Expl Wildcat Cable

- Domestic well within 330 feet: yes no
- Municipal well within one mile: yes no

If OWWO: old well info as follows:

Operator

Well Name

Comp Date Old Total Depth

Projected Total Depth 4600 feet

Projected Formation at TD Mississippi

Expected Producing Formations

Depth to Bottom of fresh water 120 155 mhc feet

Lowest usable water formation Dakota

Depth to Bottom of usable water 1100 feet

Surface pipe by Alternate: 1 2

Surface pipe to be set 320 feet

Conductor pipe if any required None feet

Ground surface elevation Unknown feet MSL

This Authorization Expires 5-8-85

Approved By 11-8-84 Hc

I certify that we will comply with K.S.A. 55-101, et seq., plus eventually plugging hole to K.C.C. specifications.

Date 11-7-84 Signature of Operator or Agent

Vice President

mhc/KOHE 11/8/84 Form C-1 4/84


Must be filed with the K.C.C. five (5) days prior to commencing well
This card void if drilling not started within six (6) months of date received by K.C.C.

RECEIVED
STATE CORPORATION COMMISSION

Important procedures to follow:

NOV 08 1984

A Regular Section of Land
1 Mile = 5,280 Ft.

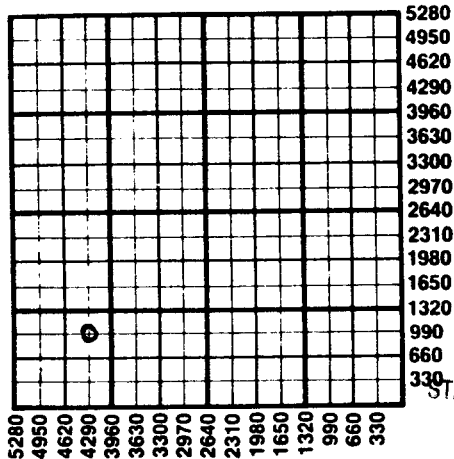

1. Notify District office before setting surface casing.
2. Set surface casing by circulating cement to the top.
3. File completion forms ACO-1 with K.C.C. within 90 days of well completion, following instructions on ACO-1, side 1, and including copies of wireline logs.
4. Notify District office 48 hours prior to old well workover or re-entry.
5. Prior to plugging, prepare a plugging plan, then obtain agreement from the appropriate district office for an approved plugging plan.
6. Submit plugging report (CP-4) to K.C.C. after plugging is completed.
7. Obtain an approved injection docket number before disposing of salt water.
8. Notify K.C.C. within 10 days when injection commences or terminates.

RECEIVED
STATE CORPORATION COMMISSION
alternate 2 completion, cement in the production pipe from below
any usable water to surface within 120 days of spud date.

State Corporation Commission of Kansas

Conservation Division

200 Colorado Derby Building

Wichita, Kansas 67202

(316) 263-3238

NOV 08 11-08-1984
CONSERVATION DIVISION
Wichita, Kansas