

CARD MUST BE TYPED

State of Kansas
NOTICE OF INTENTION TO DRILL

CARD MUST BE SIGNED

(see rules on reverse side)

Starting Date: ... Appx. June 15, 1985
month day year

API Number 15- 101-21, 176-00-00

OPERATOR: License # 5144

~~XXXXXX~~

Name Mull Drilling Company, Inc.

NW... SE... NE Sec . 21 Twp . 17 S, Rge . 29 ~~XX~~ West
(location)

Address P.O. Box 2758

..... 3630' Ft North from Southeast Corner of Section

City/State Wichita, KS... 67201

..... 990' Ft West from Southeast Corner of Section

Contact Person Patricia Ungleich

(Note: Locate well on Section Plat on reverse side)

Phone (316) 264-6366/5368

Nearest lease or unit boundary line 990' feet.

CONTRACTOR: License # .. 5651

County Lane

Name Mallard Drilling Company

Lease Name Boomhower Well# 1

City/State 405 Century Plaza Bldg., Wichita... 67202

Domestic well within 330 feet : yes no

Well Drilled For: Well Class: Type Equipment:

Municipal well within one mile : yes no

Oil Swd Infield Mud Rotary

Depth to Bottom of fresh water 150' feet

Gas Inj Pool Ext. Air Rotary

Lowest usable water formation Cheyenne

OWWO Expl Wildcat Cable

Depth to Bottom of usable water 1500' feet

If OWWO: old well info as follows:

Surface pipe by Alternate : 1 2 *See Below

Operator

Surface pipe to be set 350' feet

Well Name

Conductor pipe if any required feet

Comp Date Old Total Depth

Ground surface elevation feet MSI.

Projected Total Depth 4650' feet

This Authorization Expires 11-29-85

Projected Formation at TD... Mississippian

Approved By 5-29-85 / [Signature]

Expected Producing Formations Lansing - Marmaton

I certify that we will comply with K.S.A. 55-101, et seq., plus eventually plugging hole to K.C.C. specifications.

Date May 28, 1985
Signature of Operator or Agent Dallas E. Donner

Title Geologist

Casing will be cemented immediately.


MHC/NOTE 5-29-85

Must be filed with the K.C.C. five (5) days prior to commencing well
This card void if drilling not started within six (6) months of date received by K.C.C.

Important procedures to follow:

A Regular Section of Land

1 Mile = 5,280 Ft.

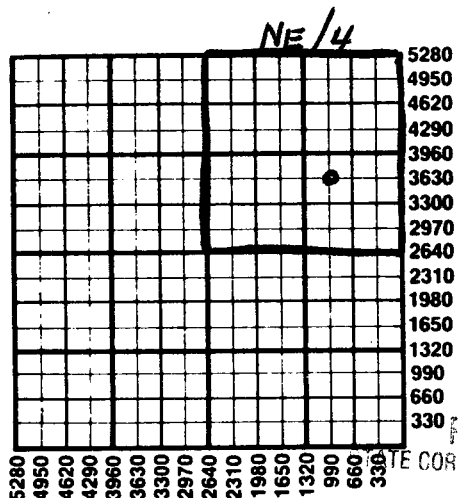

1. Notify District office before setting surface casing.
2. Set surface casing by circulating cement to the top.
3. File completion forms ACO-1 with K.C.C. within 90 days of well completion, following instructions on ACO-1, side 1, and including copies of wireline logs.
4. Notify District office 48 hours prior to old well workover or re-entry.
5. Prior to plugging, prepare a plugging plan, then obtain agreement from the appropriate district office for an approved plugging plan.
6. Submit plugging report (CP-4) to K.C.C. after plugging is completed.
7. Obtain an approved injection docket number before disposing of salt water.
8. Notify K.C.C. within 10 days when injection commences or terminates.
9. If an alternate 2 completion, cement in the production pipe from below any usable water to surface within 120 days of spud date.

RECEIVED
STATE CORPORATION COMMISSION

MAY 29 1985
05-29-1985
CONSERVATION DIVISION
Wichita, Kansas

State Corporation Commission of Kansas
Conservation Division
200 Colorado Derby Building
Wichita, Kansas 67202
(316) 263-3238