

CARD MUST BE TYPED

State of Kansas
NOTICE OF INTENTION TO DRILL
(see rules on reverse side)

COLLECTION
CARD MUST BE SIGNED 9-4-85

Starting Date:1. September. 1985.....
month day year

Corrected Card (Location changed)

API Number IS- 169-20,284 - 0000

OPERATOR: License #5057.....
Name Voigt Oil & Gas Co., Inc.
Address R R #3 Box 33-B
City/State/Zip McPherson, Kansas 67460
Contact Person Richard H. Voigt
Phone 913-227-3241

.....SW-SW-SE... Sec .28. Twp .16. S, Rge .1...
(location) East West

* 330 Ft North from Southeast Corner of Section
..... 2310 Ft West from Southeast Corner of Section
(Note: Locate well on Section Plat on reverse side)

CONTRACTOR: License #5133.....
Name Kansas Drilling & Well Service
City/State Marion, Kansas

Nearest lease or unit boundary line 330 feet.
County Saline
Lease Name Gerald Karber Well# 1

Domestic well within 330 feet : yes no
Municipal well within one mile : yes no

Well Drilled For: Well Class: Type Equipment:

Oil Swd Infield Mud Rotary
 Gas Inj Pool Ext. Air Rotary
 OWWO Expl Wildcat Cable

Depth to Bottom of fresh water 80 feet
Lowest usable water formation Wellington
Depth to Bottom of usable water 200 feet
Surface pipe by Alternate : 1 2
Surface pipe to be set 200 feet
Conductor pipe if any required none feet
Ground surface elevation 1269 feet MSL
This Authorization Expires 12-11-85
Approved By 6-11-85

If OWWO: old well info as follows:

Operator
Well Name
Comp Date Old Total Depth
Projected Total Depth 2700 feet
Projected Formation at TD Mississippian
Expected Producing Formations Mississippian

I certify that we will comply with K.S.A. 55-101, et seq., plus eventually plugging hole to K.C.C. specifications. Always: 450 FSL


Date ..21. Aug. 85... Signature of Operator or Agent Richard H. Voigt Title President.....

Must be filed with the K.C.C. five (5) days prior to commencing well
This card void if drilling not started within six (6) months of date received by K.C.C.

CONSERVATION DIVISION
Wichita, Kansas

A Regular Section of Land
1 Mile = 5,280 Ft.

RECEIVED
AUG 3 0 1955
STATE CORPORATION COMMISSION

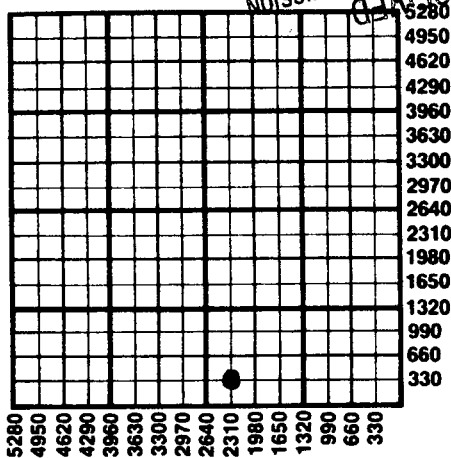

Important procedures to follow:

1. Notify District office before setting surface casing.
2. Set surface casing by circulating cement to the top.
3. File completion forms ACO-1 with K.C.C. within 90 days of well completion, following instructions on ACO-1, side 1, and including copies of wireline logs.
4. Notify District office 48 hours prior to old well workover or re-entry.
5. Prior to plugging, prepare a plugging plan, then obtain agreement from the appropriate district office for an approved plugging plan.
6. Submit plugging report (CP-4) to K.C.C. after plugging is completed.
7. Obtain an approved injection docket number before disposing of salt water.
8. Notify K.C.C. within 10 days when injection commences or terminates.
9. If an alternate 2 completion, cement in the production pipe from below any usable water to surface within 120 days of spud date.

State Corporation Commission of Kansas
Conservation Division
200 Colorado Derby Building
Wichita, Kansas 67202
(316) 263-3238