

CARD MUST BE TYPED

State of Kansas
NOTICE OF INTENTION TO DRILL
(see rules on reverse side)

CARD MUST BE SIGNED

Starting Date: September 8, 1985
month day year

API Number 15- 169-20, 287-0000
 East

OPERATOR: License # 5120

N/2 N/2 NE Sec 18 Twp 16 S, Rge 1... West
(location)

Name Range Oil Company, Inc.

Address 240 Page Court; 220 West Douglas

City/State/Zip Wichita, KS 67202

Contact Person John Washburn

Phone (316) 265-6231

..... 4950 Ft North from Southeast Corner of Section

..... 1320 Ft West from Southeast Corner of Section

(Note: Locate well on Section Plat on reverse side)

CONTRACTOR: License # 5124

Name Range Drilling Company, Inc.

City/State Wichita, KS 67202

Nearest lease or unit boundary line 330 feet.

County Saline

Lease Name Nelson "C" Well# 2

Domestic well within 330 feet : yes no

Municipal well within one mile : yes no

Well Drilled For: Well Class: Type Equipment:

Oil Swd Infield Mud Rotary

Gas Inj Pool Ext. Air Rotary

OWWO Expl Wildcat Cable

Depth to Bottom of fresh water 90 feet

Lowest usable water formation Wellington

Depth to Bottom of usable water 200 feet

Surface pipe by Alternate : 1 2

Surface pipe to be set 200 feet

Conductor pipe if any required feet

Ground surface elevation 1320 feet MSL

This Authorization Expires 2-15-86

Approved By 8-15-85
[Signature]

If OWWO: old well info as follows:

Operator

Well Name

Comp Date Old Total Depth

Projected Total Depth 2740 feet

Projected Formation at TD Mississippian

Expected Producing Formations Mississippian

I certify that we will comply with K.S.A. 55-101, et seq., plus eventually plugging hole to K.C.C. specifications.

Date .. 8-15-85 Signature of Operator or Agent .. *[Signature]* ..

..... Title .. Exploration Mgr.

Must be filed with the K.C.C. five (5) days prior to commencing well
This card void if drilling not started within six (6) months of date received by K.C.C.


RECEIVED
STATE CORPORATION COMMISSION

AUG 15 1985

Important procedures to follow :

A Regular Section of Land
1 Mile = 5,280 Ft.

CONSERVATION DIVISION
Wichita, Kansas

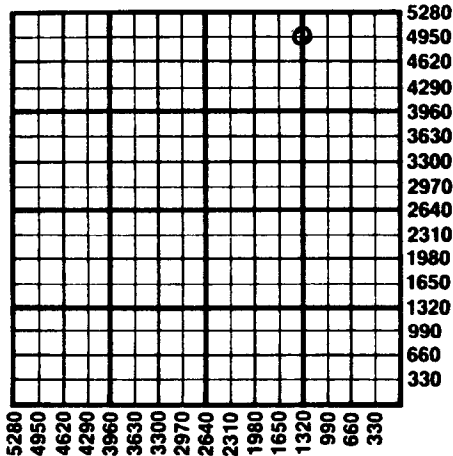

1. Notify District office before setting surface casing.
2. Set surface casing by circulating cement to the top.
3. File completion forms ACO-1 with K.C.C. within 90 days of well completion, following instructions on ACO-1, side 1, and including copies of wireline logs.
4. Notify District office 48 hours prior to old well workover or re-entry.
5. Prior to plugging, prepare a plugging plan, then obtain agreement from the appropriate district office for an approved plugging plan.
6. Submit plugging report (CP-4) to K.C.C. after plugging is completed.
7. Obtain an approved injection docket number before disposing of salt water.
8. Notify K.C.C. within 10 days when injection commences or terminates.
9. If an alternate 2 completion, cement in the production pipe from below any usable water to surface within 120 days of spud date.

State Corporation Commission of Kansas
Conservation Division
200 Colorado Derby Building
Wichita, Kansas 67202
(316) 263-3238