

CARD MUST BE TYPED

State of Kansas

CARD MUST BE SIGNED

NOTICE OF INTENTION TO DRILL

(see rules on reverse side)

Expected Spud Date..... 7 28 87
month day year

API Number 15— 101-21,404-0000
NE NE SW Sec. 36 Twp. 17 S, Rg. 29W West

OPERATOR: License # 6194
Name ESP DEVELOPMENT, INC.
Address RR #1, Box 18
City/State/Zip Paradise, KS 67658
Contact Person Bud Eulert
Phone 913-998-4413

2310 Ft. from South Line of Section
2970 Ft. from East Line of Section
(Note: Locate well on Section Plat on reverse side)

CONTRACTOR: License # 5302
Name Red Tiger Drilling Co.
City/State Wichita, KS 67202

Nearest lease or unit boundary line 330 feet
County Lane
Lease Name Riley "B" Well # 1

Well Drilled For: Well Class: Type Equipment:
 Oil Storage Infield Mud Rotary
 Gas Inj Pool Ext. Air Rotary
 OWWO Expl Wildcat Cable

Ground surface elevation feet MSL
Domestic well within 330 feet: yes no
Municipal well within one mile: yes no

If OWWO: old well info as follows:
Operator
Well Name
Comp Date Old Total Depth

Depth to bottom of fresh water..... 250
Depth to bottom of usable water 1425
Surface pipe by Alternate: 1 2

I certify that well will comply with K.S.A. 55-101, et seq. as eventually changing hole to KCC specifications.
Date 7-23-87 Signature of Operator or Agent George A. Ortle OWNER


For KCC Use:
Conductor Pipe Required feet; Minimum Surface Pipe Required 250 feet per Alt. 1 2
This Authorization Expires 1-23-88 Approved By PH 7-23-87

Must be filed with the K.C.C. five (5) days prior to commencing well
This card void if drilling not started within six (6) months of date received by K.C.C.

Important procedures to follow:

1. Notify District office before setting surface casing.
2. Set surface casing by circulating cement to the top.
3. File completion forms ACO-1 with K.C.C. within 120 days of well spud date, following instructions on ACO-1, side 1, and including copies of wireline logs.
4. Notify District office 48 hours prior to old well workover or re-entry.
5. Prior to filing Intent, prepare a proposed plugging plan in case well is D & A, then obtain approval of plan when calling district office prior to setting surface pipe.
6. Submit plugging report (CP-4) to K.C.C. after plugging is completed.
7. Obtain an approved injection docket number before disposing of salt water.
8. Notify K.C.C. within 10 days when injection commences or terminates.
9. If an alternate 2 completion, cement in the production pipe from below any usable water to surface within 120 days of spud date.

A Regular Section of Land 1 Mile = 5,280 Ft.

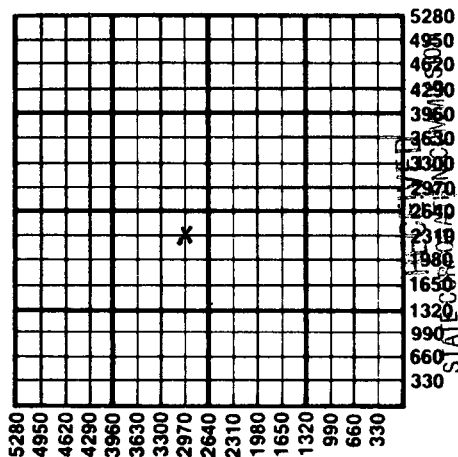

JUL 23 1987
7-23-87
CONSERVATION DIVISION
Wichita, Kansas

State Corporation Commission of Kansas
Conservation Division
200 Colorado Derby Building
Wichita, Kansas 67202-1212
(316) 263-3238