

CARD MUST BE TYPED

State of Kansas
NOTICE OF INTENTION TO DRILL
(see rules on reverse side)

CARD MUST BE SIGNED

Starting Date: February 9, 1985

API Number 15- 101-21,128-00-00

month day year

C N/2 SW NW Sec 18 Twp 17S S, Rge 29W East West

OPERATOR: License # 5171

3630' Ft North from Southeast Corner of Section
~~4220~~ 4630' Ft West from Southeast Corner of Section
(Note: Locate well on Section Plat on reverse side)

Name TXO Production Corp.

Address 200 W. Douglas Ste #300

City/State/Zip Wichita, Ks. 67202

Contact Person Gary Wurdeman

Phone (316) 265-9441

CONTRACTOR: License # 6033

Name Murfin Drilling Co.

City/State Wichita, Kansas 67202

Well Drilled For: Well Class: Type Equipment:

Oil Swd Infield Mud Rotary

Gas Inj Pool Ext. Air Rotary

OWWO Expl Wildcat Cable

If OWWO: old well info as follows:

Operator

Well Name

Comp Date

Projected Total Depth 4600' Old Total Depth

Projected Formation at TD Cherokee Im

Expected Producing Formations Cherokee Im

Nearest lease or unit boundary line 660' feet.

County Lane

Lease Name Grusing Well# #1

Domestic well within 330 feet: yes no

Municipal well within one mile: yes no

Depth to Bottom of fresh water 100' 150' MHC feet

Lowest usable water formation Dakota

Depth to Bottom of usable water 400' 1100' feet

Surface pipe by Alternate: 2" 4" 

Surface pipe to be set 4" 2" 450' feet

Conductor pipe if any required

Ground surface elevation

This Authorization Expires 8-4-85

Approved By 3-4-85

I certify that we will comply with K.S.A. 55-101, et seq., plus eventually plugging hole to K.C.C. specifications.

Date 2-4-85 Signature of Operator or Agent

Jerry W. Collins

Title Drilling & Completion Engr.


Form C-1 4/84

MHC/KOHE 2-4-85

**Must be filed with the K.C.C. five (5) days prior to commencing well
This card void if drilling not started within six (6) months of date received by K.C.C.**

Important procedures to follow :

**A Regular Section of Land
1 Mile = 5,280 Ft.**

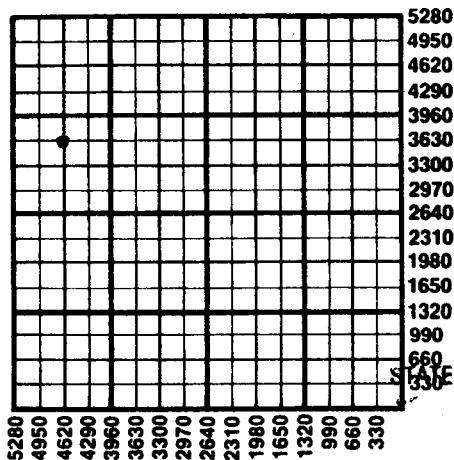

1. Notify District office before setting surface casing.
 2. Set surface casing by circulating cement to the top.
 3. File completion forms ACO-1 with K.C.C. within 90 days of well completion, following instructions on ACO-1, side 1, and including copies of wireline logs.
 4. Notify District office 48 hours prior to old well workover or re-entry.
 5. Prior to plugging, prepare a plugging plan, then obtain agreement from the appropriate district office for an approved plugging plan.
 6. Submit plugging report (CP-4) to K.C.C. after plugging is completed.
 7. Obtain an approved injection docket number before disposing of salt water.
 8. Notify K.C.C. within 10 days when injection commences or terminates.
- If an alternate 2 completion, cement in the production pipe from below any usable water to surface within 120 days of spud date.

RECEIVED
STATE CORPORATION COMMISSION

FEB 4 1985

CONSERVATION DIVISION
Wichita, Kansas

02-04-1985

State Corporation Commission of Kansas
Conservation Division
200 Colorado Derby Building
Wichita, Kansas 67202
(316) 263-3238