

NOTICE OF INTENTION TO DRILL

(see rules on reverse side)

Starting Date February 12 1986 month day year

API Number 15- 101-21,289-0000

OPERATOR: License # 5104

NE SE SE Sec. 9 Twp 18 S, Rg. 27 East West

Name Blue Goose Drilling Company, Inc.

Address P.O. Box 1413

City/State/Zip Great Bend, KS 67530

Contact Person Martin E. Miller

Phone 316-792-5633

990 Ft. from South Line of Section 330 Ft. from East Line of Section

(Note: Locate well on Section Plat on reverse side)

CONTRACTOR: License # same

Name Company Tools

City/State

Nearest lease or unit boundary line 330 feet County Lane

Lease Name Borell "B" Well # 1

Ground surface elevation feet MSL

Domestic well within 330 feet: yes X no

Municipal well within one mile: yes X no

Well Drilled For: Well Class: Type Equipment:

X Oil SWD Infield X Mud Rotary

Gas Inj Pool Ext Air Rotary

OWWO Expl Wildcat Cable

Depth to bottom of fresh water 100'

Depth to bottom of usable water 1000'

Surface pipe by Alternate: 1 2 X

Surface pipe planned to be set 240

Conductor pipe required

Projected Total Depth 4650 feet

Formation Mississippi

If OWWO: old well info as follows:

Operator

Well Name

Comp Date Old Total Depth

I certify that well will comply with K.S.A. 55-101, et seq., plus eventually plugging hole to KCC specifications.

Date 2/7/86 Signature of Operator or Agent Title Contract Representative

For KCC Use:

Conductor Pipe Required feet; Minimum Surface Pipe Required 200 feet per Alt. X 2

This Authorization Expires 8-10-86 Approved By 2-10-86


Signature

Must be filed with the K.C.C. five (5) days prior to commencing well
This card void if drilling not started within six (6) months of date received by K.C.C.

Important procedures to follow:

1. Notify District office before setting surface casing.
2. Set surface casing by circulating cement to the top.
3. File completion forms ACO-1 with K.C.C. within 90 days of well completion, following instructions on ACO-1, side 1, and including copies of wireline logs.
4. Notify District office 48 hours prior to old well workover or re-entry.
5. Prior to filing Intent, prepare a proposed plugging plan in case well is D & A, then obtain approval of plan when calling district office prior to setting surface pipe.
6. Submit plugging report (CP-4) to K.C.C. after plugging is completed.
7. Obtain an approved injection docket number before disposing of salt water.
8. Notify K.C.C. within 10 days when injection commences or terminates.
9. If an alternate 2 completion, cement in the production pipe from below any usable water to surface within 120 days of spud date.

A Regular Section of Land
1 Mile = 5,280 Ft.

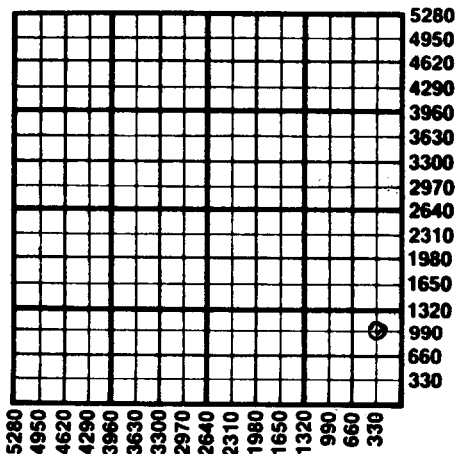

RECEIVED
STATE CORPORATION COMMISSION
2-10-86
FEB 10 1986
CONSERVATION DIVISION
Wichita Kansas

State Corporation Commission of Kansas
Conservation Division
200 Colorado Derby Building
Wichita, Kansas 67202
(316) 263-3238