

CARD MUST BE TYPED

State of Kansas
NOTICE OF INTENTION TO DRILL
(see rules on reverse side)

CARD MUST BE SIGNED

Starting Date: February 12 1986
month day year

OPERATOR: License # 5104
Name Blue Goose Drilling Company, Inc.
Address P.O. Box 1413
City/State/Zip Great Bend, KS 67530
Contact Person Martin E. Miller
Phone 316 792-5633

CONTRACTOR: License # same
Name Company Tools
City/State

Well Drilled For: Well Class: Type Equipment:
 Oil Swd Infield Mud Rotary
 Gas Inj Pool Ext. Air Rotary
 OWWO Expl Wildcat Cable

If OWWO: old well info as follows:

Operator Beren Corporation
Well Name #1 Weiser
Comp Date 1/27/82 Old Total Depth 4603
Projected Total Depth 2033 feet
Projected Formation at TD Anhydrite
Expected Producing Formations N/A

I certify that we will comply with K.S.A. 55-101, et seq., plus eventually plugging hole to K.C.C. specifications.

Date 2/5/86 Signature of Operator or Agent [Signature] Title

API Number 15- 101-20,573-X0001
NE..NW..SE.. Sec .9.. Twp 18.. S, Rge .27. East
(location) West
2310 Ft North from Southeast Corner of Section
1650 Ft West from Southeast Corner of Section
(Note: Locate well on Section Plat on reverse side)

Nearest lease or unit boundary line 330 feet.
County Lane
Lease Name Borell Well# SWDW!
Domestic well within 330 feet: yes no
Municipal well within one mile: yes no


Depth to Bottom of fresh water 100 feet
Lowest usable water formation Dakota
Depth to Bottom of usable water 1000 feet
Surface pipe by Alternate: 1 2
Surface pipe set 320 feet
Conductor pipe if any required feet
Ground surface elevation 2651 feet MSL
This Authorization Expires 8-10-86
Approved By 2-10-86 [Signature]

Contract Representative [Signature]
Form C-1 4/84

Must be filed with the K.C.C. five (5) days prior to commencing well
This card void if drilling not started within six (6) months of date received by K.C.C.

Important procedures to follow :

**A Regular Section of Land
1 Mile = 5,280 Ft.**

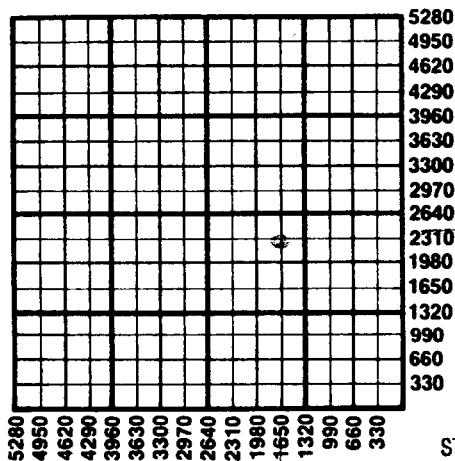

1. Notify District office before setting surface casing.
2. Set surface casing by circulating cement to the top.
3. File completion forms ACO-1 with K.C.C. within 90 days of well completion, following instructions on ACO-1, side 1, and including copies of wireline logs.
4. Notify District office 48 hours prior to old well workover or re-entry.
5. Prior to plugging, prepare a plugging plan, then obtain agreement from the appropriate district office for an approved plugging plan.
6. Submit plugging report (CP-4) to K.C.C. after plugging is completed.
7. Obtain an approved injection docket number before disposing of salt water.
8. Notify K.C.C. within 10 days when injection commences or terminates.
9. If an alternate 2 completion, cement in the production pipe from below any usable water to surface within 120 days of spud date.

RECEIVED
STATE CORPORATION COMMISSION
FEB 10 1986
2-10-86
CONSERVATION DIVISION
Wichita, Kansas

State Corporation Commission of Kansas
Conservation Division
200 Colorado Derby Building
Wichita, Kansas 67202
(316) 263-3238