

CARD MUST BE TYPED

State of Kansas
NOTICE OF INTENTION TO DRILL
(see rules on reverse side)

CARD MUST BE SIGNED

Starting Date: ..7..... July 18 85
month day year

API Number 15- 169-20,285-0000

OPERATOR: License # 4490
Name Hubert W. Redden Family Partnership
Address Gypsum Kansas
City/State/Zip Gypsum, Kansas 67448
Contact Person Hubert W. Redden
Phone 913.536.4479

165, s. of nw nese Sec 20. Twp 16. S, Rge 1. East
(location) West

.2145..... Ft North from Southeast Corner of Section
990..... Ft West from Southeast Corner of Section
(Note: Locate well on Section Plat on reverse side)

CONTRACTOR: License # 5133
Name Kansas Drilling & Well Service Inc.
City/State Box 254 Marion, Kansas

Nearest lease or unit boundary line feet.
County Saline

Lease Name Redden Well# 1

Domestic well within 330 feet : yes no

Municipal well within one mile : yes no

Well Drilled For: Well Class: Type Equipment:
 Oil Swd Infield Mud Rotary
 Gas Inj Pool Ext. Air Rotary
 OWWO Expl Wildcat Cable

Depth to Bottom of fresh water 85 feet

Lowest usable water formation ~~x200x~~ feet

Depth to Bottom of usable water ~~200~~ 200 feet

Surface pipe by Alternate: 1 2

Surface pipe to be set 200 feet

Conductor pipe if any required N.R. feet

Ground surface elevation feet MSL

This Authorization Expires 1-17-86

Approved By 7-17-85 *RC*

I certify that we will comply with K.S.A. 55-101, et seq., plus eventually plugging holes to K.C.C. specifications.

Date 7-12-85 Signature of Operator or Agent

Paul D. ... Title


Agent
RCN for KOHE



**Must be filed with the K.C.C. five (5) days prior to commencing well
This card void if drilling not started within six (6) months of date received by K.C.C.**

Important procedures to follow :

**A Regular Section of Land
1 Mile = 5,280 Ft.**

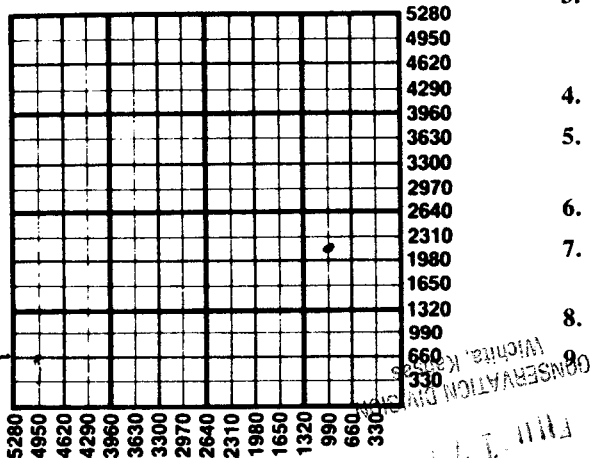

1. Notify District office before setting surface casing.
 2. Set surface casing by circulating cement to the top.
 3. File completion forms ACO-1 with K.C.C. within 90 days of well completion, following instructions on ACO-1, side 1, and including copies of wireline logs.
 4. Notify District office 48 hours prior to old well workover or re-entry.
 5. Prior to plugging, prepare a plugging plan, then obtain agreement from the appropriate district office for an approved plugging plan.
 6. Submit plugging report (CP-4) to K.C.C. after plugging is completed.
 7. Obtain an approved injection docket number before disposing of salt water.
 8. Notify K.C.C. within 10 days when injection commences or terminates.
9. If an alternate 2 completion, cement in the production pipe from below any usable water to surface within 120 days of spud date.

RECEIVED
 STATE CORPORATION COMMISSION
 FILE 173
 CONSERVATION DIVISION
 WICHITA, KANSAS

**State Corporation Commission of Kansas
Conservation Division
200 Colorado Derby Building
Wichita, Kansas 67202
(316) 263-3238**